


1 TELECOM PLAN  
SU3.06 1"=20'

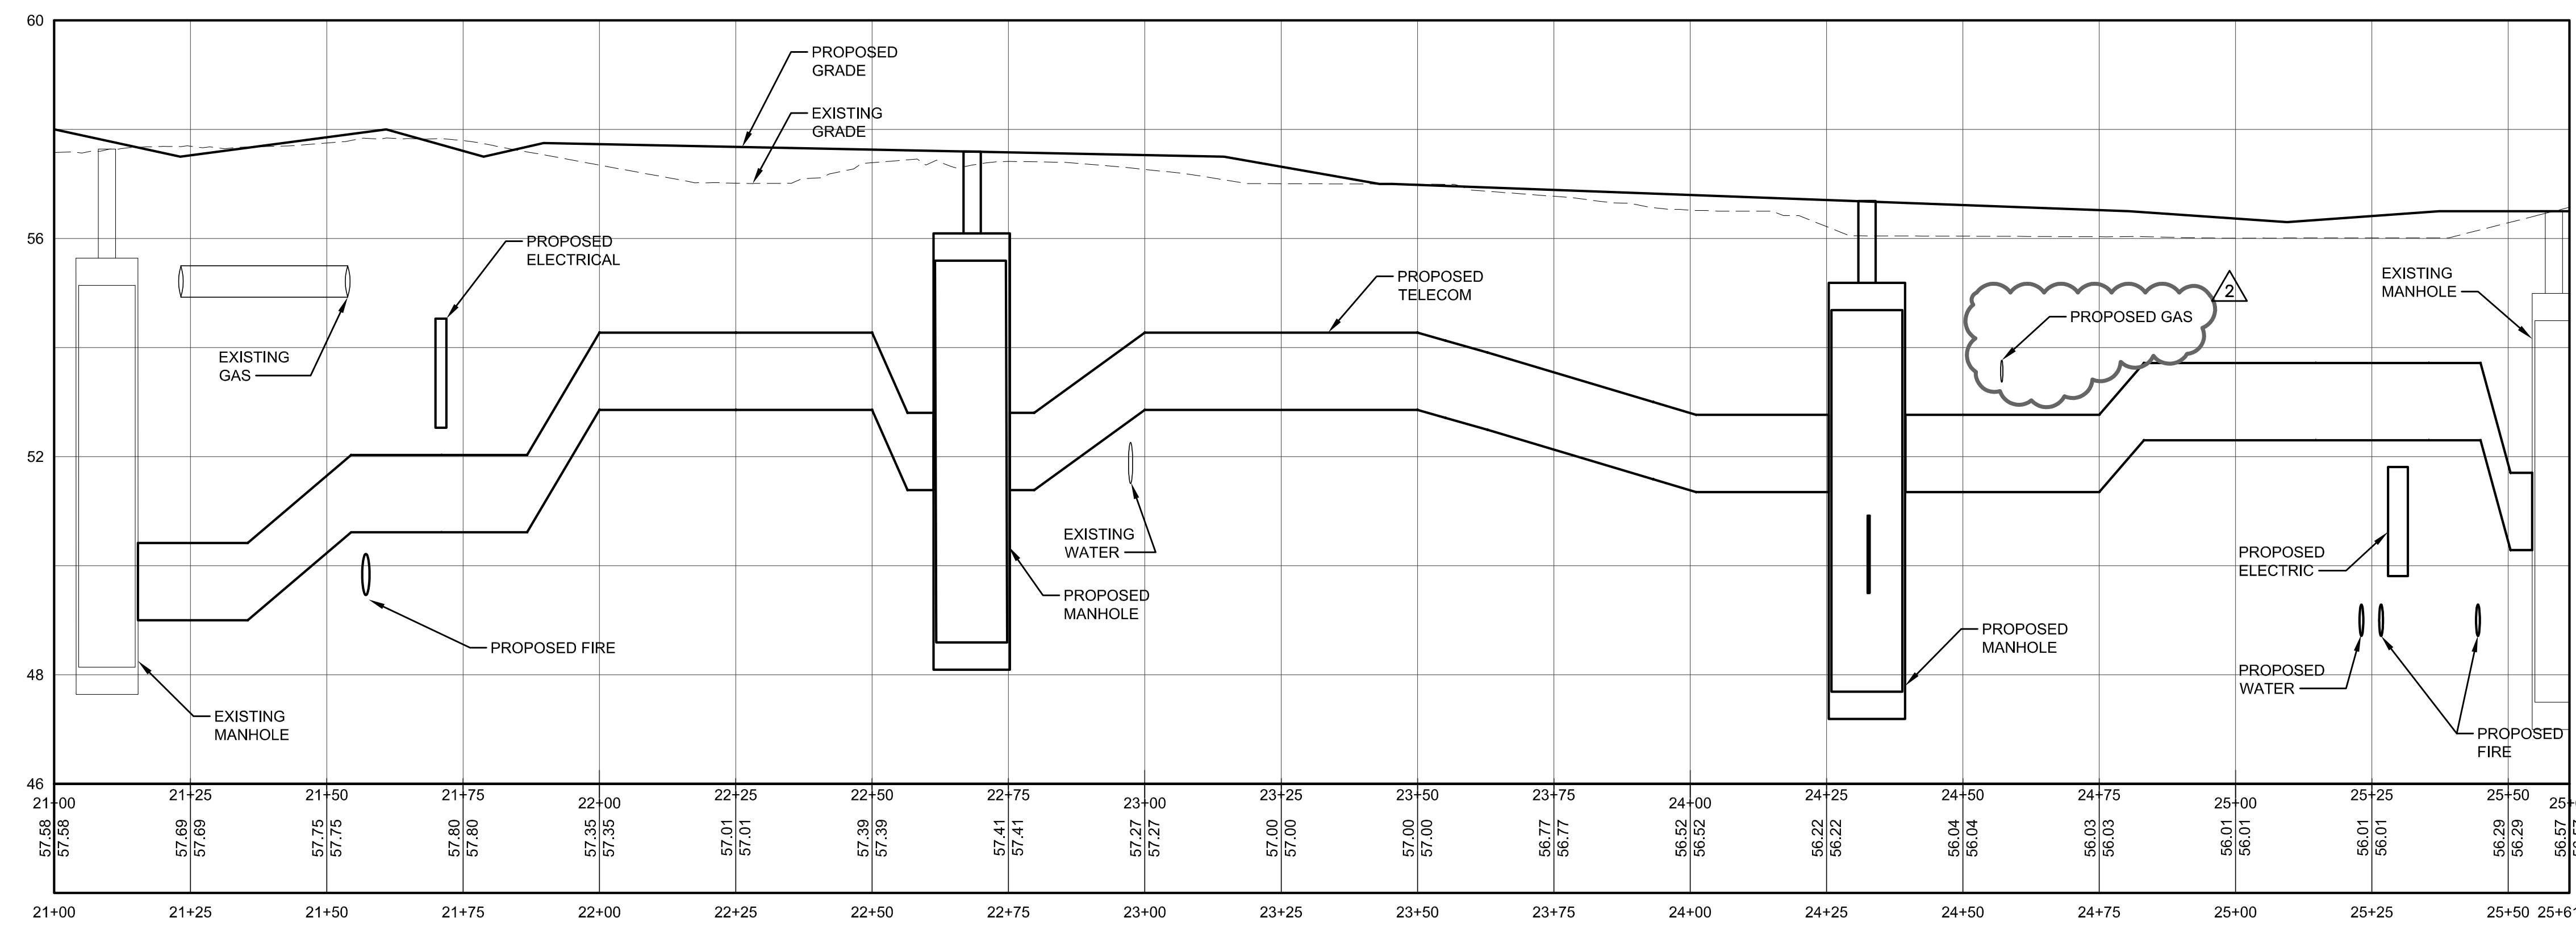


2 TELECOM PROFILE  
SU3.06 H:1"=20' V:1"=2'

**PLAN AND PROFILE GENERAL NOTES:**

1. INFORMATION REGARDING THE LOCATION OF EXISTING UTILITIES HAS BEEN BASED UPON AVAILABLE INFORMATION AND MAY BE INCOMPLETE AND WHERE SHOWN SHOULD BE CONSIDERED APPROXIMATE.
2. LOCATIONS OF EXISTING UTILITIES SHOWN ON PROFILE DRAWINGS NOT RELATED TO STORM OR SANITARY I.E. "ELECTRICAL", "TELECOMMUNICATIONS", "GAS" ETC. ARE BASED ON ASSUMED TYPICAL COVER REQUIREMENTS AND HAVE NOT BEEN FIELD VERIFIED.
3. LOCATIONS OF EXISTING STORM AND SANITARY SHOWN ON PROFILE DRAWINGS ARE BASED ON INVERTS PROVIDED BY THE SURVEY AND CALCULATED PIPE SLOPES TO DETERMINE INVERT ELEVATIONS AT CROSSINGS OF PROPOSED UTILITIES.
4. IT IS THE RESPONSIBILITY OF THE CONTRACTOR TO VERIFY LOCATIONS OF EXISTING UTILITIES PRIOR TO INSTALLATION OF NEW WORK. MEANS AND METHODS FOR VERIFICATION OF EXISTING UTILITIES TO BE DETERMINED BY THE CONTRACTOR AND COORDINATED WITH THEIR CONSTRUCTION ACTIVITIES. THE ENGINEER SHALL BE NOTIFIED OF ANY DISCREPANCIES AT A MINIMUM OF THREE (3) BUSINESS DAYS IN ADVANCE OF SCHEDULED INSTALLATION OF NEW WORK. ANY NEW WORK THAT IS INSTALLED WITHOUT PRIOR VERIFICATION OF EXISTING UTILITIES THAT REQUIRES REMOVAL AND REINSTALLATION SHALL BE PERFORMED AT NO COST TO THE OWNER.

**GRAPHIC SCALES**

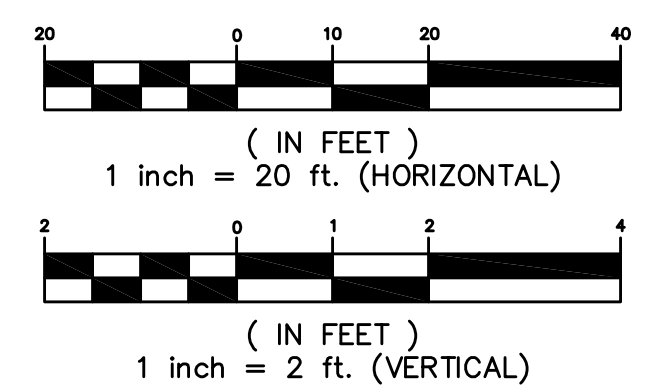

drawing title TELECOM PLAN AND PROFILE		STATE OF CONNECTICUT DEPARTMENT OF ADMINISTRATIVE SERVICES	
professional seal	REVISIONS		drawing prepared by BVH INTEGRATED SERVICES 208 WEST NEWBERRY ROAD BLOOMFIELD, CT, 06002
	mark	date	description
	01	08/16/2019	DOCUMENTS FOR BID
	02	09/25/2019	ADDENDUM #3
	project SCSU NEW HHS BUILDING 501 CRESCENT STREET NEW HAVEN, CT 06050		date 08/16/2019 scale AS NOTED
	project no. BHS-329		drawn by ALP approved by JRV drawing no. SU3.06