PURCHASING DEPARTMENT

The bid listed below has had addenda issued. Documents are available over the Internet at http://www.norwalkct.gov Adobe Acrobat reader is required to view this document. If you do not have this software you may download it free from Adobe. The document number to request will be the same as the project number indicated below.

Project #	Addendum #	# of Pages	Original Issue Date
4304	1	10	07/14/2023

Addendum Issued Date	08/11/2023	
Project Number	4304	
Addenda Number	1	
Electronic Deadline	2:00 PM	~~08/14/2023~~ 08/28/2023
Hard Copy Deadline	2:00 PM	~~08/16/2023~~ 08/30/2023
Project Title	TMP2023-2 EAST WALL STREET - LANDMARK SQUARE SAFETY, ACCESSIBILITY AND STREETSCAPE STATE L102-0004	

This Addendum is a contract document modifying previously issued documents, which remain in full force except as specifically modified below.

Quotations appearing on the Proposal are to reflect the provisions of this Addendum. Failure to acknowledge receipt of this Addendum in the space provided on the response sheet may subject candidate to disqualification.

NEW INFORMATION:

1. **CLARIFICATION:** The attached Typical Sections have been revised to clarify the material composition of the amenity strip "brick pavers" consistent with plan page STP-01 and specification MDS-11.
2. **REVISED SUBMISSION DATES:** The following dates have updated due to the clarification issued in this addendum.

	TIME	DATE
Electronic Submission Deadline	2:00PM	MONDAY, AUGUST 28, 2023
Hard Copy Submission Deadline	2:00PM	WEDNESDAY, AUGUST 30, 2023
Bid Opening	2:00PM	WEDNESDAY, AUGUST 30, 2023

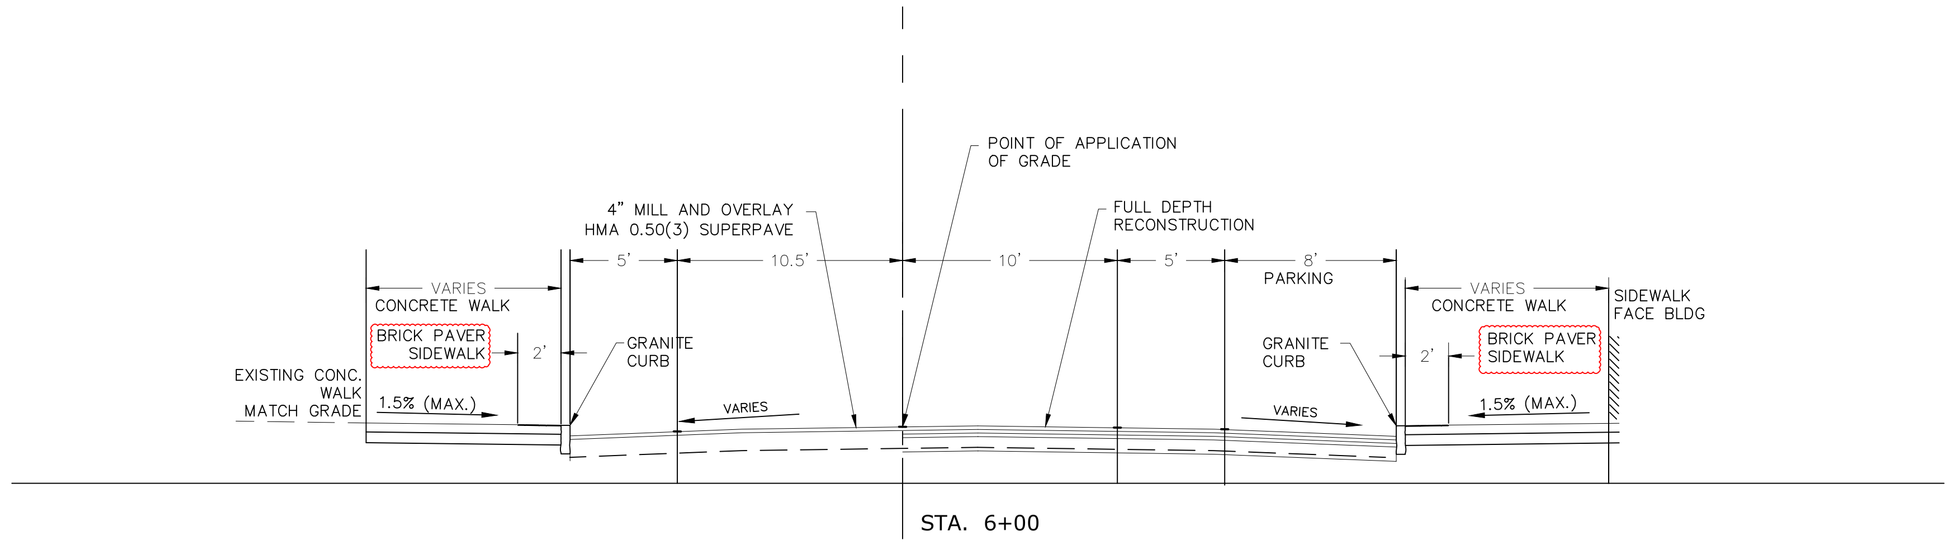

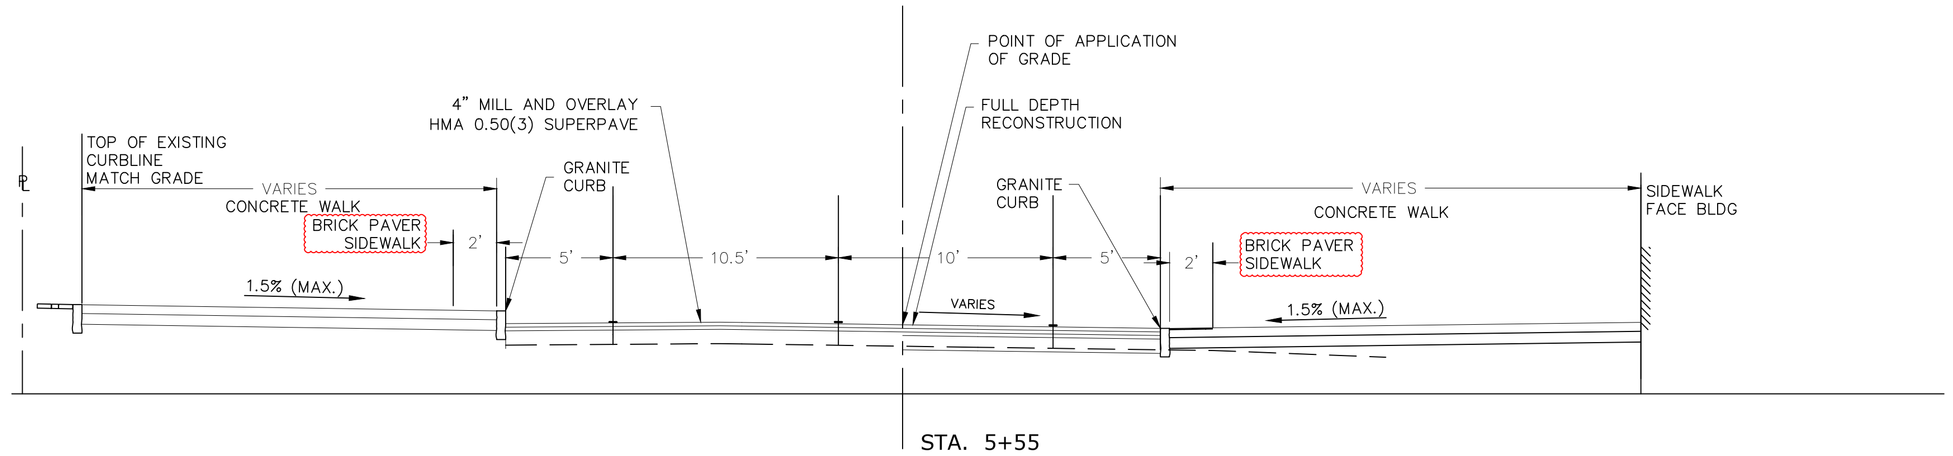

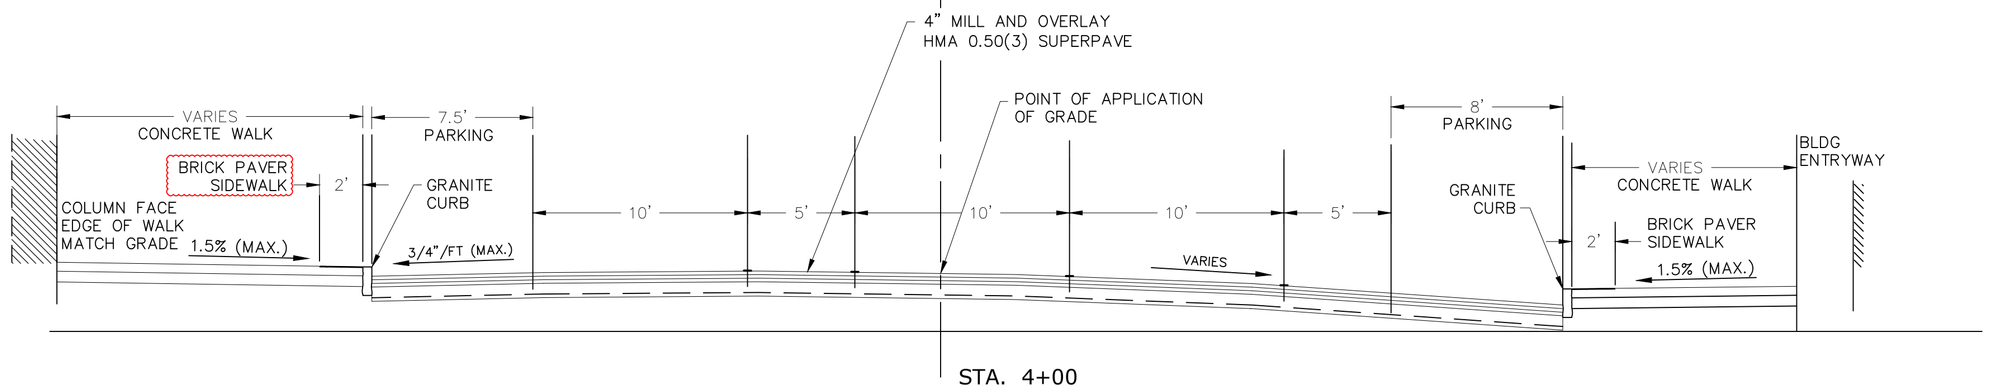

	A	B	C	D	E	F
	A – E X"=STONE SIZE & (Y)=LEVEL e.g. 0.50"(3)					
	0.375"(2)	0.50"(2)	1.00"(2)	0.50"(3)	1.00"(3)	P.A.B.
STATE ROAD				3"	6"	12"
MAJOR ARTERIAL				4"	4"	14"
MINOR ARTERIAL	1.5"	2"	3"			12"
COLLECTOR	1.5"	1.5"	3"			12"
LOCAL	3"					12"

STONE SIZE	LIFT THICKNESS	
	MIN.	MAX.
0.375"	1.5"	2"
0.50"	1.75"	2.5"
1.00"	3.0"	5.0"

PAVEMENT REPAIR TABLE
(SUPERPAVE)

NOTE: EAST WALL STREET IS CLASSIFIED AS A MAJOR ARTERIAL FOR PAVEMENT COMPOSITION PURPOSES.

No.	DATE	DESCRIPTION	DESIGNER	REVIEWER
1.	8/10/2023	REVISED STAMPED CONCRETE TO BRICK PAVER SIDEWALK	TJR	MGV

SEAL

SEAL

SCALE:
HORZ.: 1" = 5'
VERT.: 1"=5'
DATUM:
HORZ.:
VERT.:
5 2.5 0 5
GRAPHIC SCALE

FUSS & O'NEILL
146 HARTFORD ROAD
MANCHESTER, CONNECTICUT 06040
860.646.2469
www.fando.com

CITY OF NORWALK

TYPICAL SECTIONS

EAST WALL STREET IMPROVEMENTS

NORWALK CONNECTICUT

PROJ. No.: L102-004
DATE: JUNE 2023

TYP-01

Page 2 of 10, Addendum 1 430X-FINAL
File: J:\DWG\P2021\03\01A10\Civil\Plan\East Wall St\202103O1.A10_TYP01.dwg Layout: TYP-01 Plotted: 2023-08-10 3:27 PM Saved: 2023-08-10 3:26 PM User: trudolph
PC3: AUTOCAD PDF (GENERAL DOCUMENTATION).PC3 STB/CTB: FO.STB
LAYER STATE:
MS VIEW:

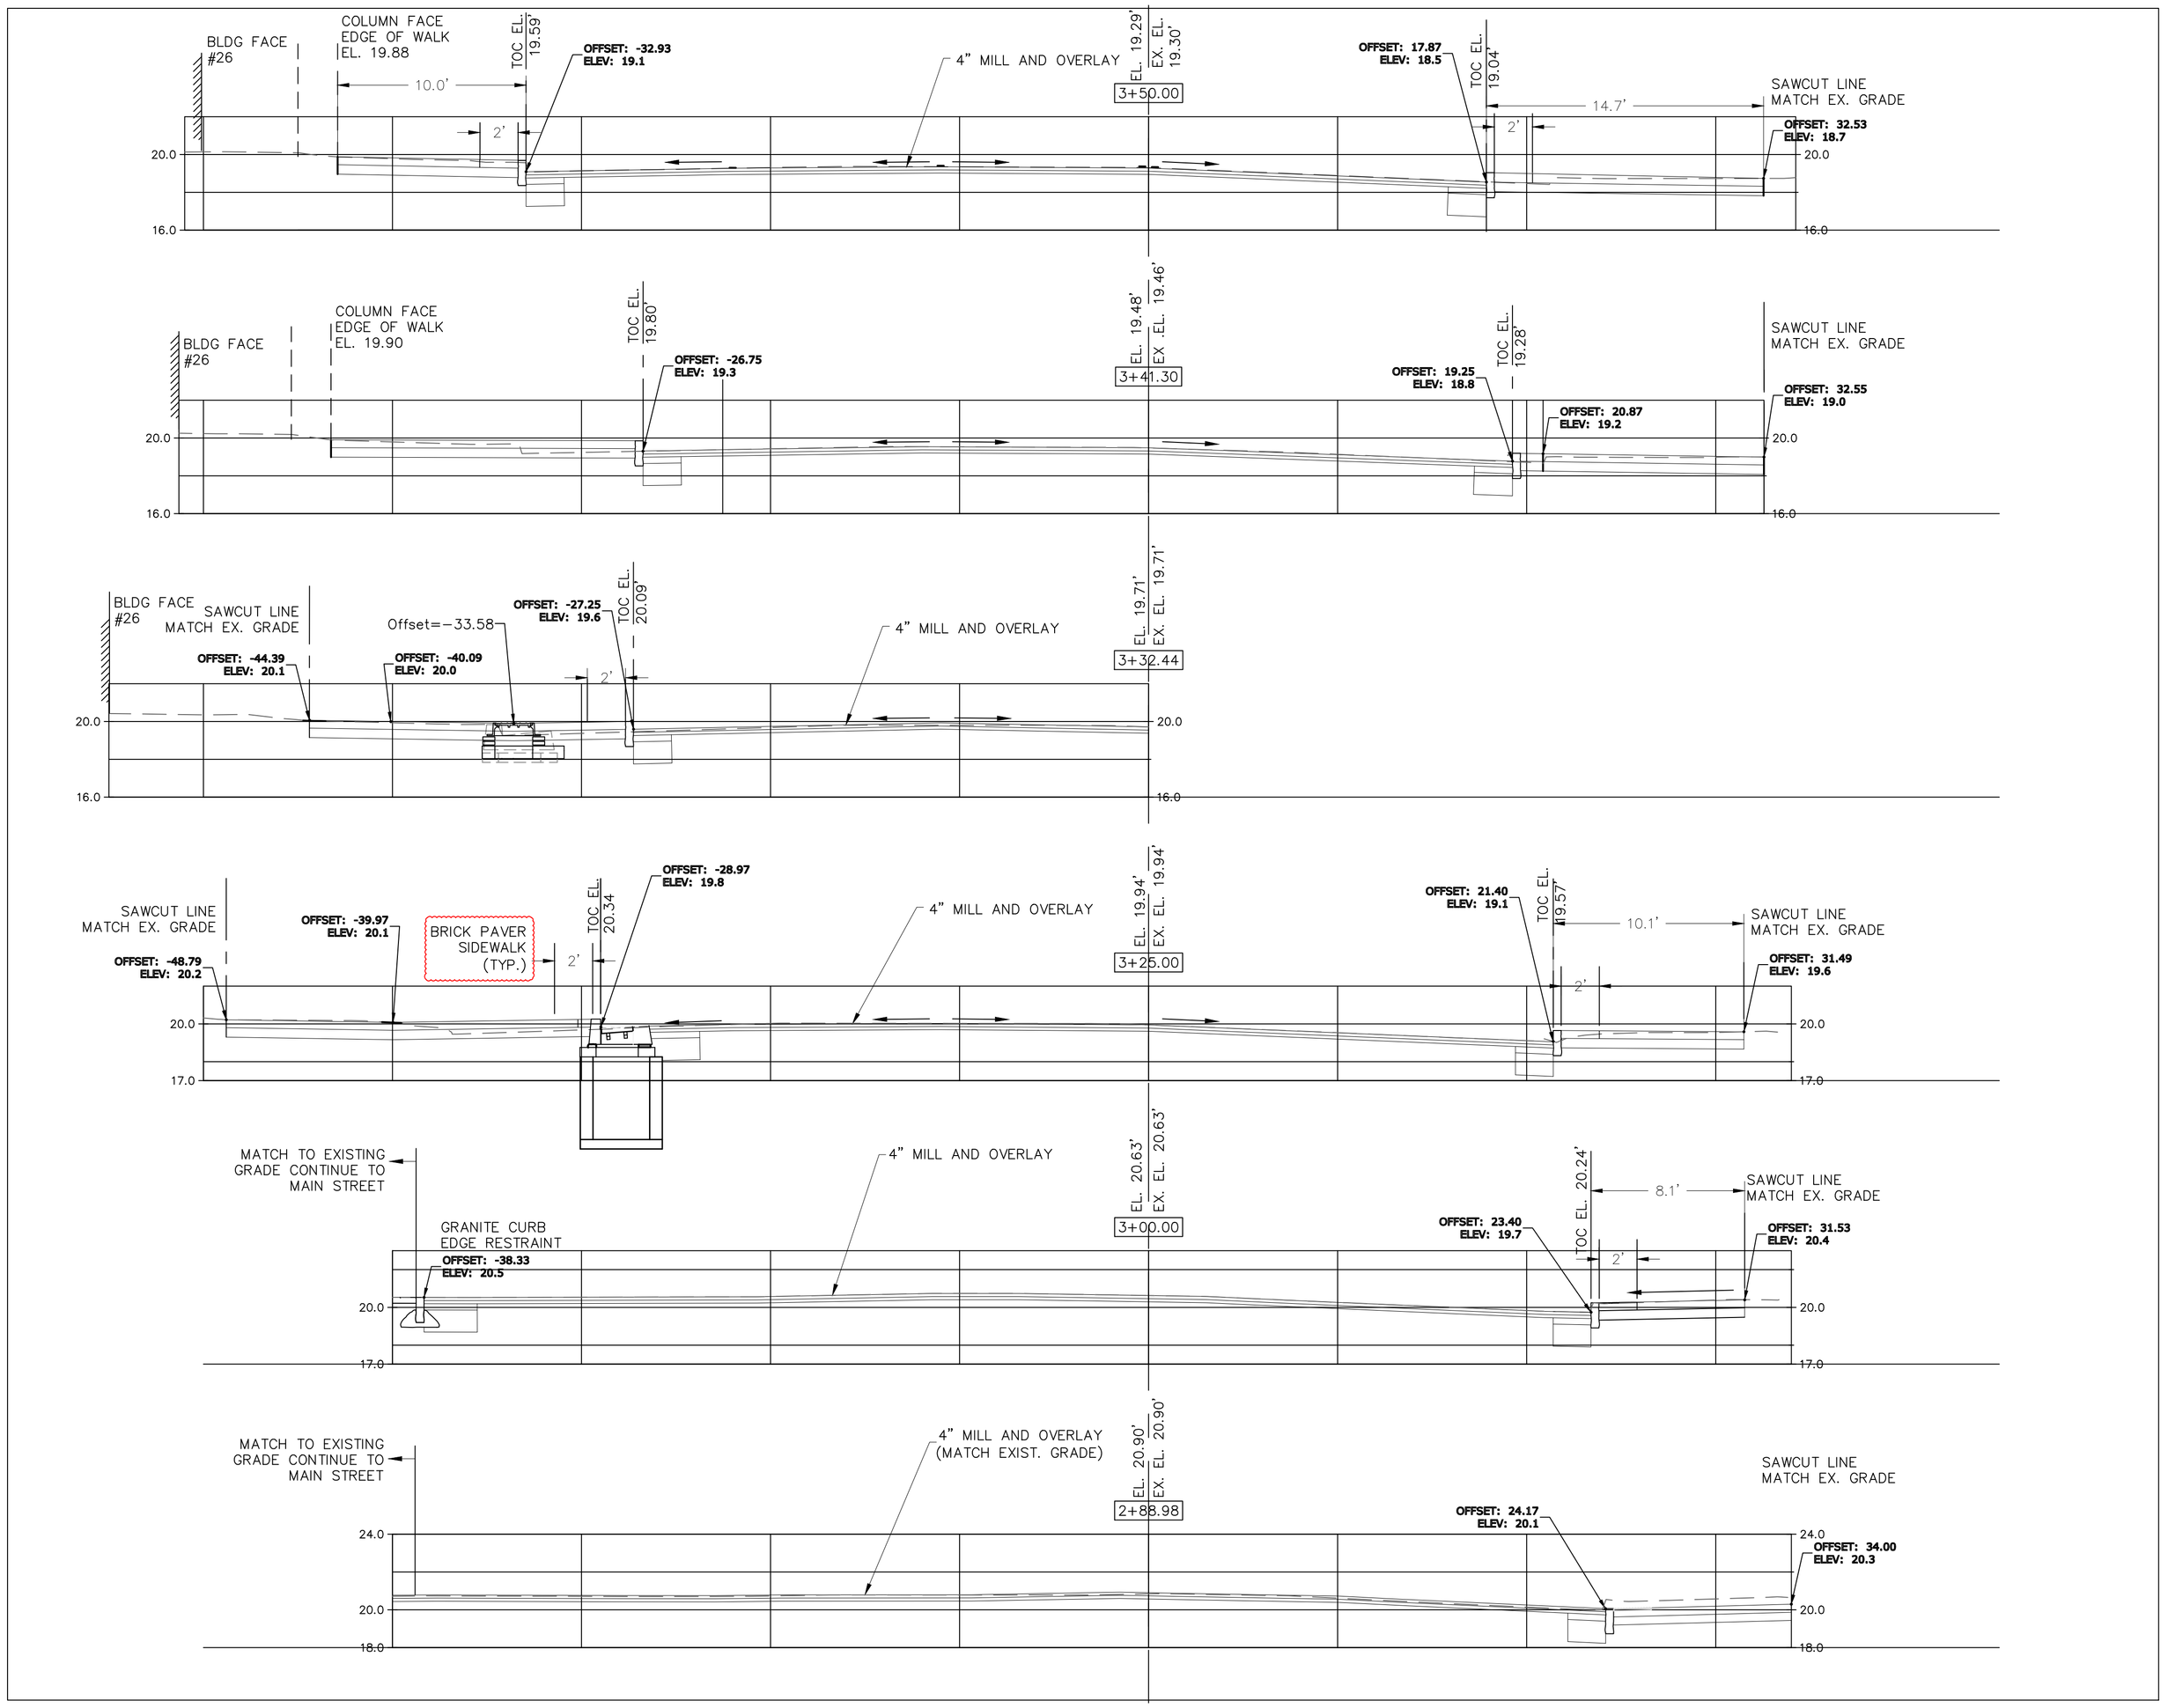

NOTE: 1. SEE CITY STANDARD DETAIL DRAWINGS NUMBER _9_ AND _10b_ FOR SIDEWALK, PAVEMENT AND CURBING.
2. SANITARY SEWER ONLY SHOWN WHERE IT HAS POTENTIAL OF CONFLICTING WITH PROPOSED STORM DRAINAGE IMPROVEMENTS.

No.	DATE	DESCRIPTION	DESIGNER	REVIEWER
1.	8/10/2023	REVISED STAMPED CONCRETE TO BRICK PAVER SIDEWALK	TJR	MGV

SEAL

SEAL

SCALE:
HORZ.: 1" = 5'
VERT.: 1"=5'
DATUM:
HORZ.:
VERT.:
5 2.5 0 5
GRAPHIC SCALE

FUSS & O'NEILL
146 HARTFORD ROAD
MANCHESTER, CONNECTICUT 06040
860.646.2469
www.fando.com

CITY OF NORWALK

CROSS-SECTION PLANS

EAST WALL STREET IMPROVEMENTS

NORWALK CONNECTICUT

PROJ. No.: L102-004
DATE: JUNE 2023

XCS-01

File: J:\DWG\P2021\03001\A10\Civil\Plan\East Wall St\20210301 A10_TYP01.dwg Layout: XSC-01 Plotted: 2023-08-10 3:27 PM Saved: 2023-08-10 3:26 PM User: trudolph
PC3: AUTOCAD PDF (GENERAL DOCUMENTATION).PC3 STB/CTB: FO.STB
LAYER STATE:
MS VIEW:
Page 3 of 10, Addendum 1 4304-FINAL

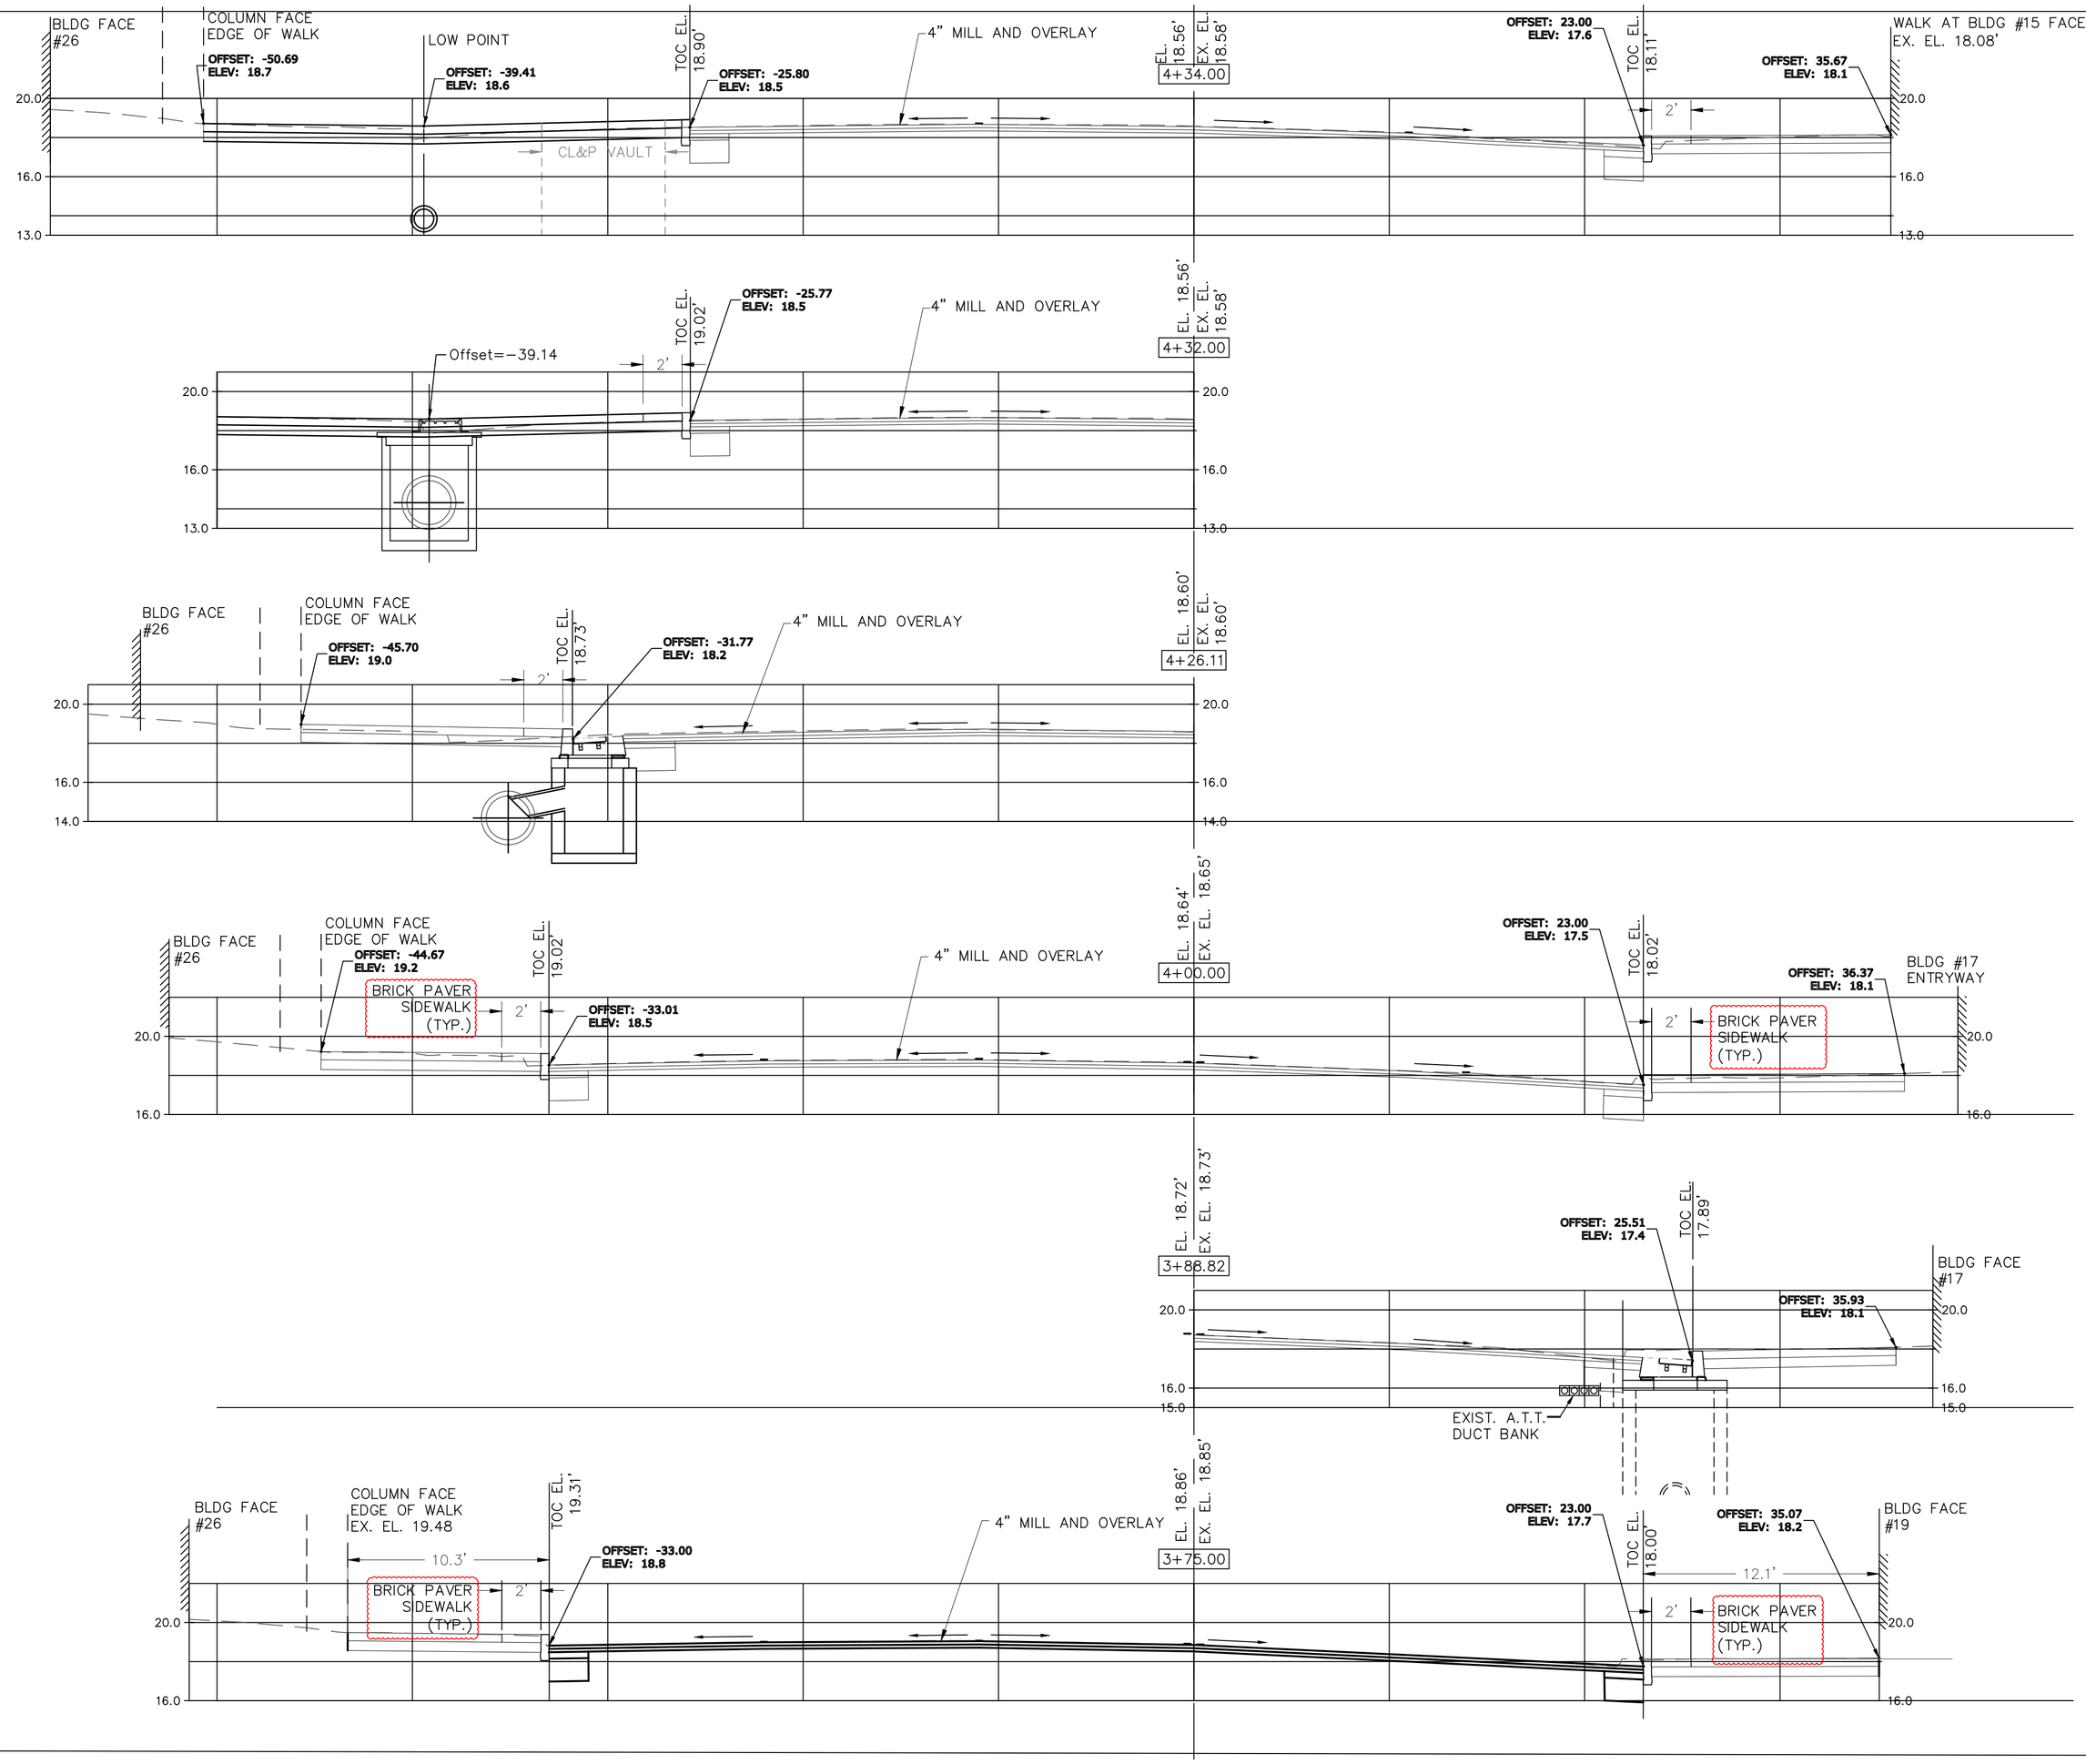

NOTE: 1. SEE CITY STANDARD DETAIL DRAWINGS NUMBER _9_ AND _10b_ FOR SIDEWALK, PAVEMENT AND CURBING.
2. SANITARY SEWER ONLY SHOWN WHERE IT HAS POTENTIAL OF CONFLICTING WITH PROPOSED STORM DRAINAGE IMPROVEMENTS.

No.	DATE	DESCRIPTION	DESIGNER	REVIEWER
1.	8/10/2023	REVISED STAMPED CONCRETE TO BRICK PAVER SIDEWALK	TJR	MGV

SEAL

SEAL

SCALE:
HORZ.: 1" = 5'
VERT.: 1"=5'
DATUM:
HORZ.:
VERT.:
5 2.5 0 5
GRAPHIC SCALE

FUSS & O'NEILL
146 HARTFORD ROAD
MANCHESTER, CONNECTICUT 06040
860.646.2469
www.fando.com

CITY OF NORWALK

CROSS-SECTION PLANS

EAST WALL STREET IMPROVEMENTS

NORWALK CONNECTICUT

PROJ. No.: L102-004
DATE: JUNE 2023

XCS-02

Page 4 of 10, Addendum 1 4304-FINAL
File: J:\DWG\P2021\03\01\A10\Civil\Plan\East Wall St\20210301.A10_TYP01.dwg Layout: XSC-02 Plotted: 2023-08-10 3:27 PM Saved: 2023-08-10 3:26 PM User: trudolph
PC3: AUTOCAD PDF (GENERAL DOCUMENTATION).PC3 STB/CTB: FO.STB
LAYER STATE:
MS VIEW:

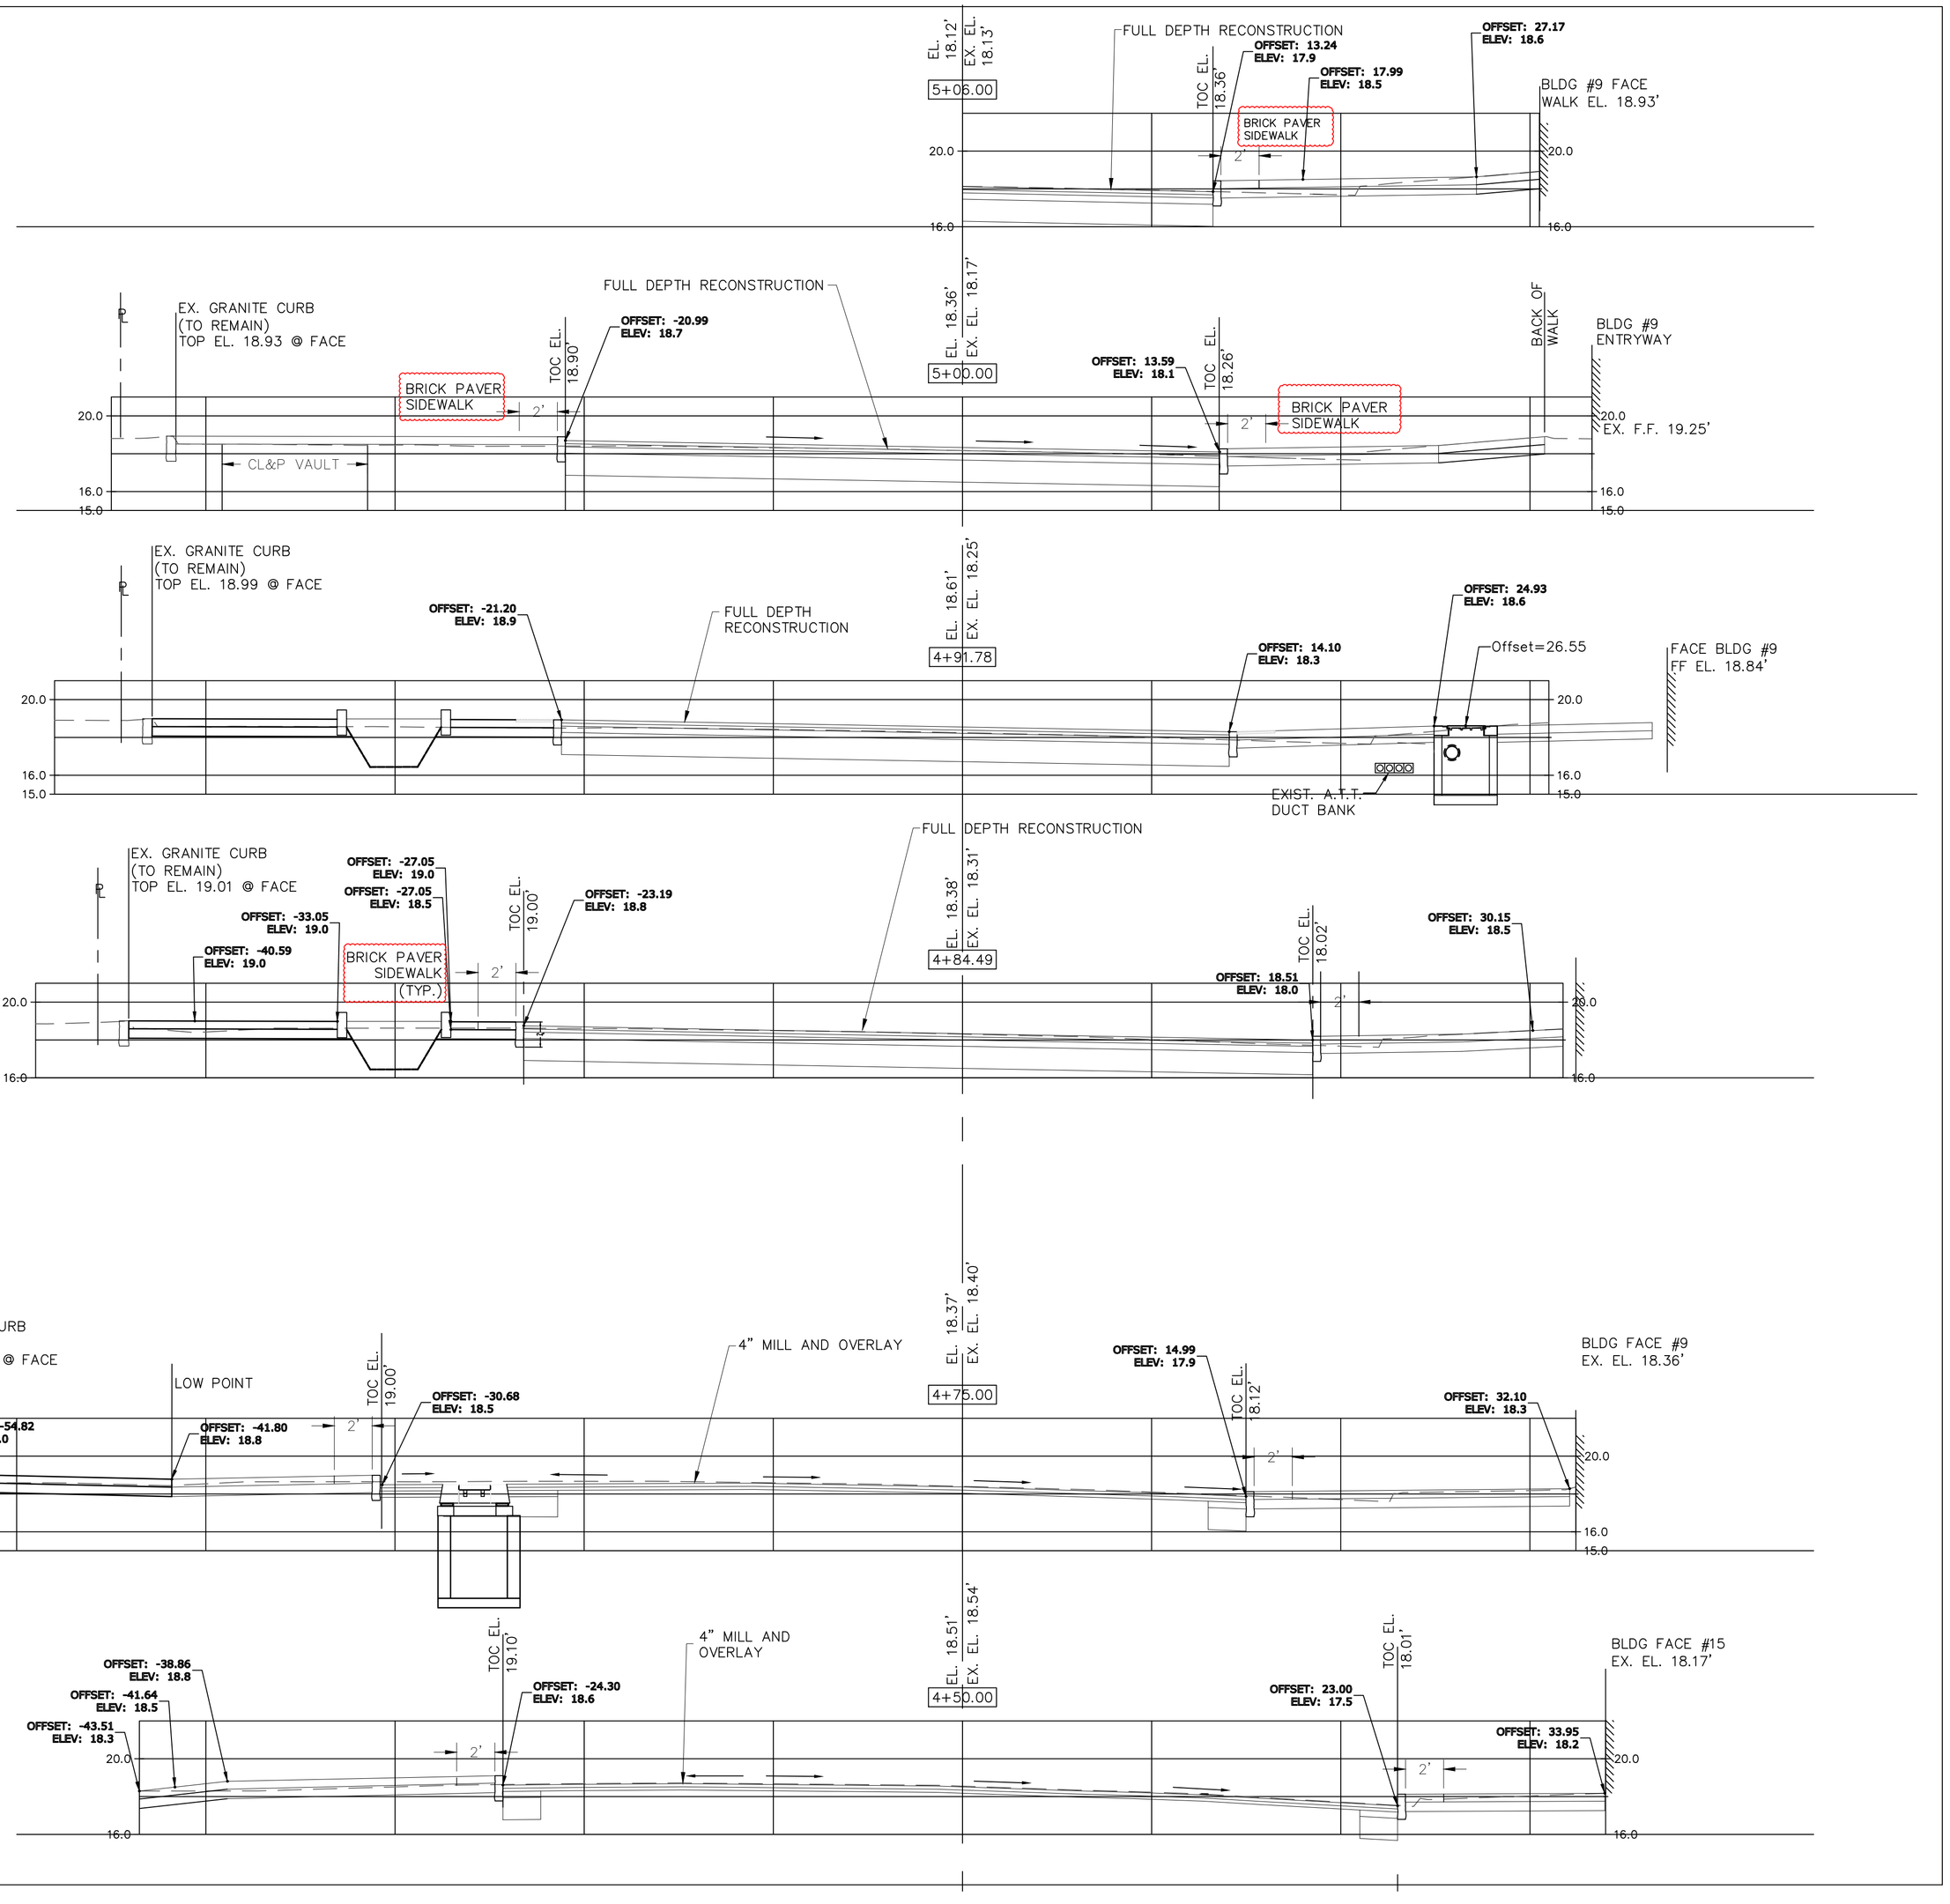

NOTE: 1. SEE CITY STANDARD DETAIL DRAWINGS NUMBER _9_ AND _10b_ FOR SIDEWALK, PAVEMENT AND CURBING.
2. SANITARY SEWER ONLY SHOWN WHERE IT HAS POTENTIAL OF CONFLICTING WITH PROPOSED STORM DRAINAGE IMPROVEMENTS.

No.	DATE	DESCRIPTION	DESIGNER	REVIEWER
1.	8/10/2023	REVISED STAMPED CONCRETE TO BRICK PAVER SIDEWALK	TJR	MGV

SEAL

SEAL

SCALE:
HORZ.: 1" = 5'
VERT.: 1"=5'
DATUM:
HORZ.:
VERT.:
5 2.5 0 5
GRAPHIC SCALE

FUSS & O'NEILL
146 HARTFORD ROAD
MANCHESTER, CONNECTICUT 06040
860.646.2469
www.fando.com

CITY OF NORWALK

CROSS-SECTION PLANS

EAST WALL STREET IMPROVEMENTS

NORWALK CONNECTICUT

PROJ. No.: L102-004
DATE: JUNE 2023

XCS-03

File: J:\DWG\P2021\0301\A10\Civil\Plan\East Wall St\20210301.A10_TYP01.dwg Layout: XSC-03 Plotted: 2023-08-10 3:27 PM Saved: 2023-08-10 3:26 PM User: trudolph
PC3: AUTOCAD PDF (GENERAL DOCUMENTATION).PC3 STB/CTB: FO.STB
LAYER STATE:
MS VIEW:
Page 9 of 10, Addendum 1 430-FINAL

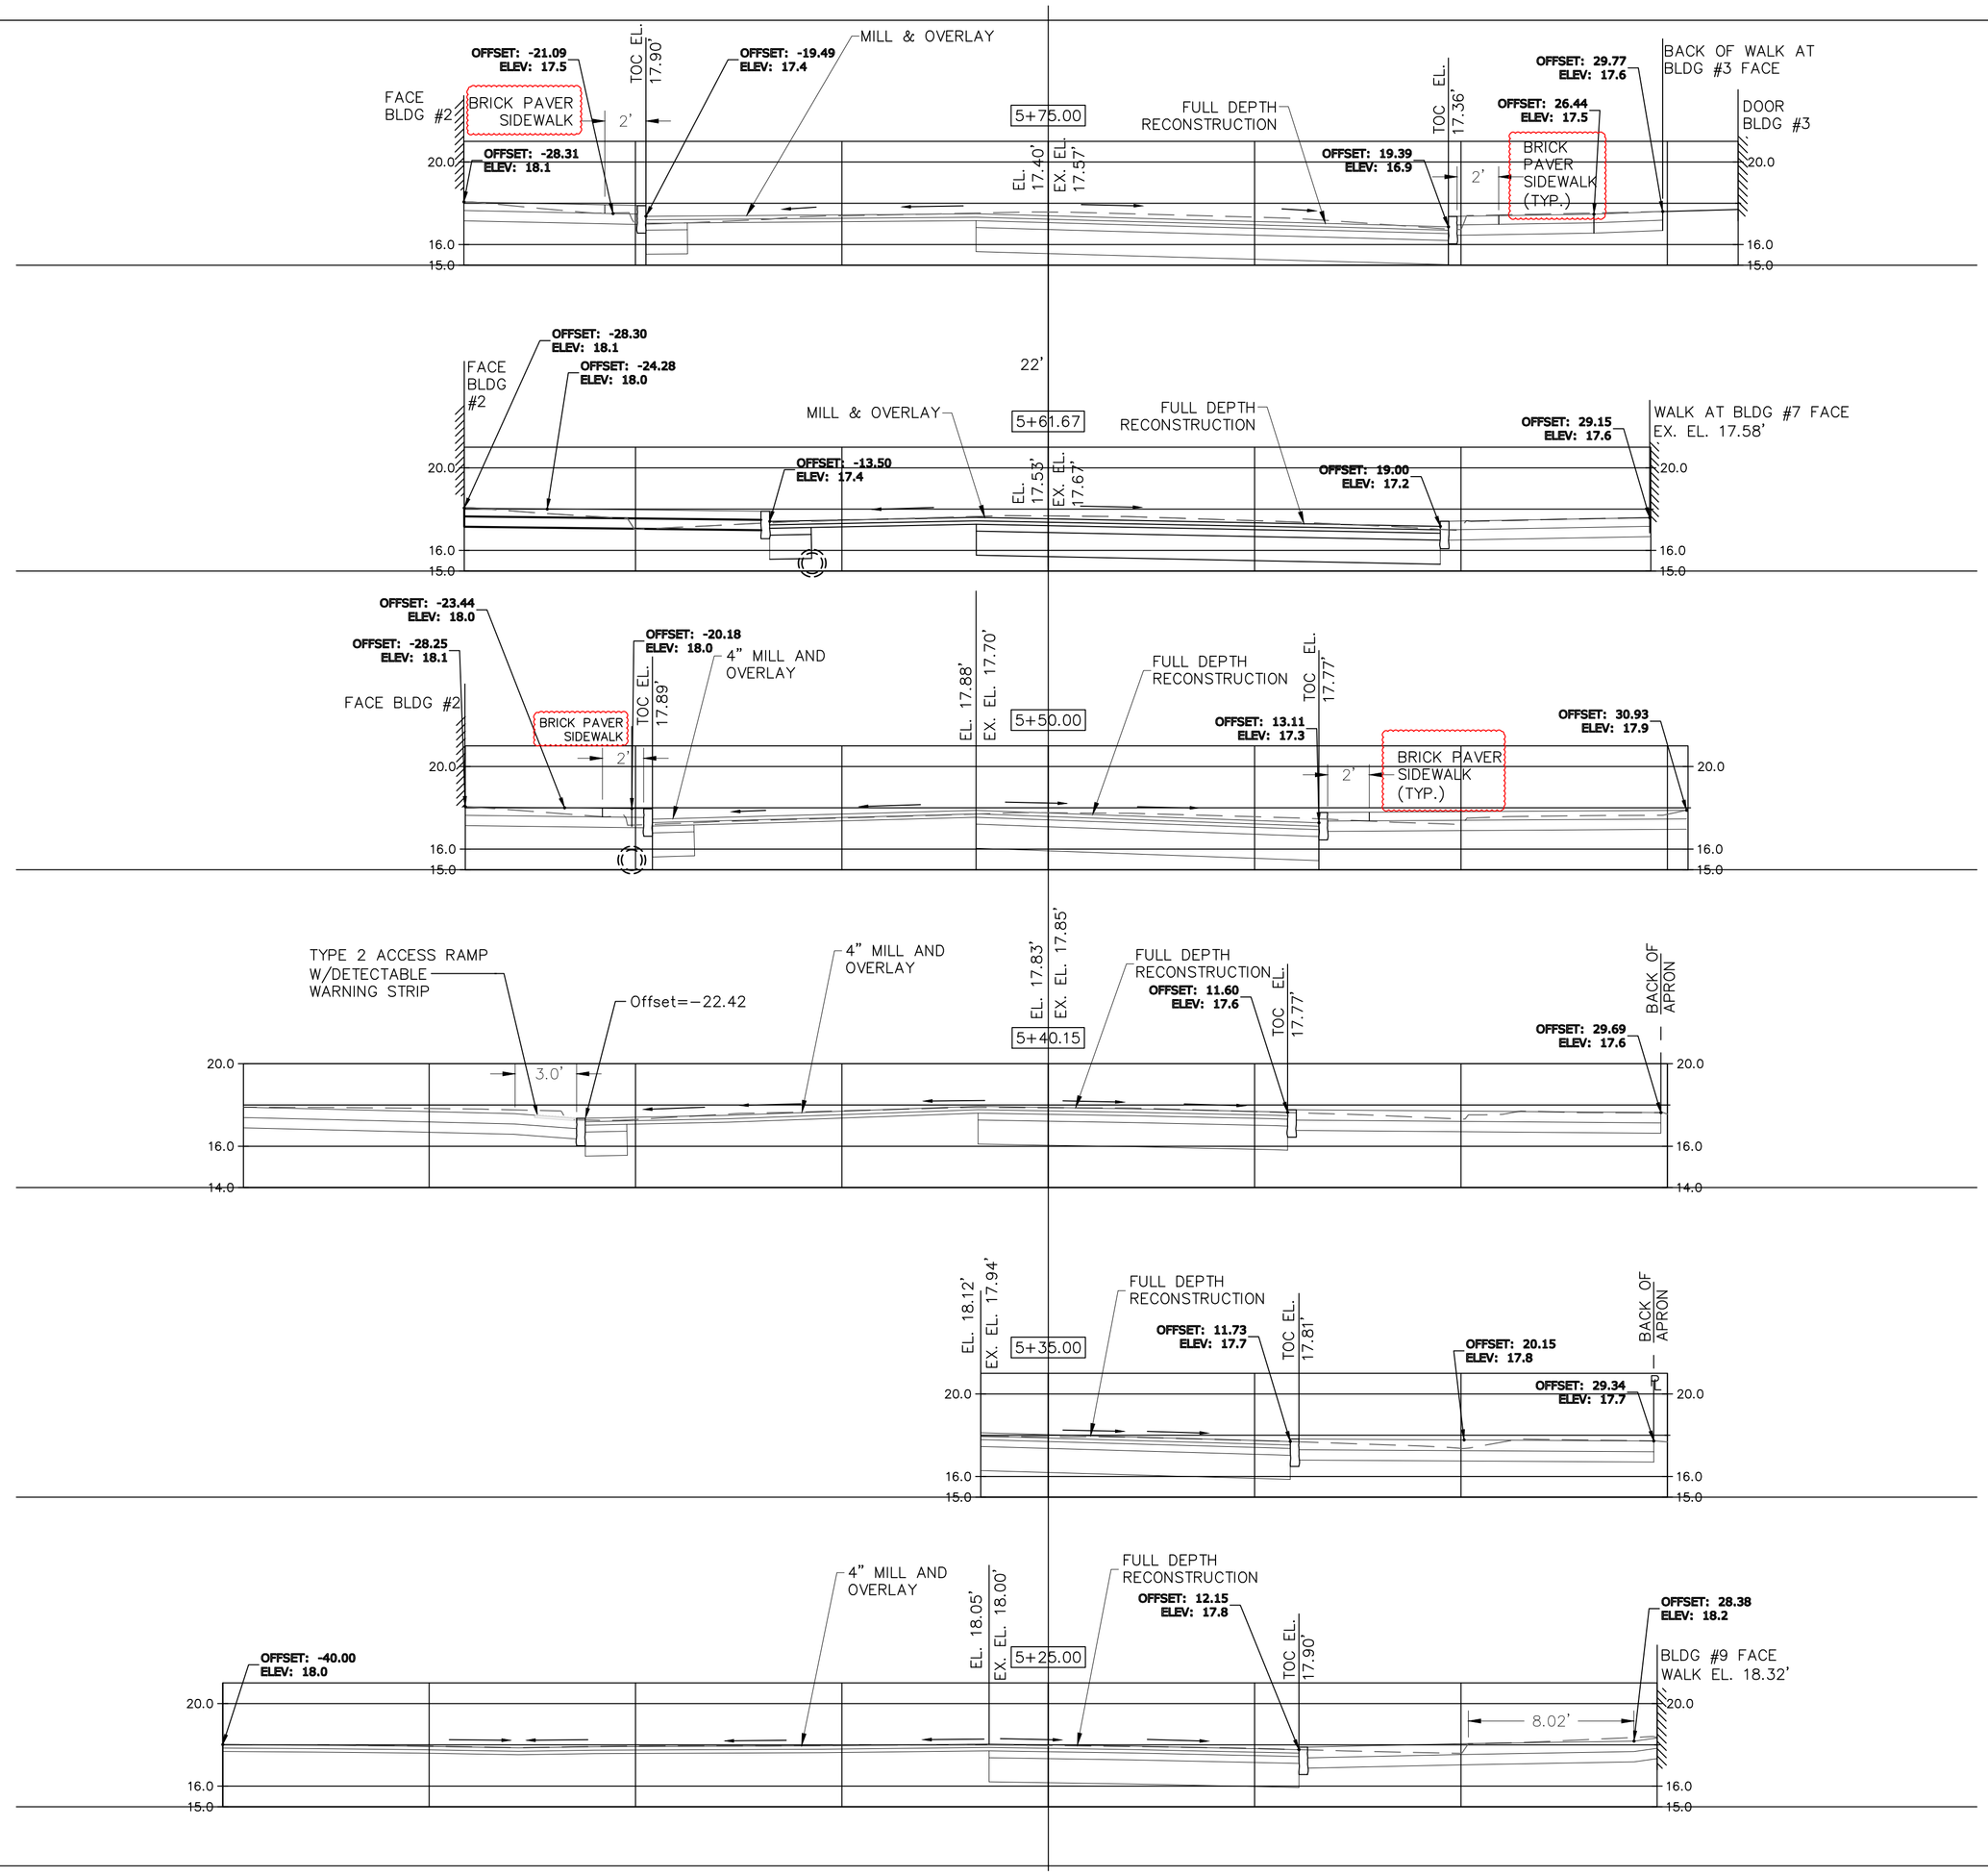

NOTE: 1. SEE CITY STANDARD DETAIL DRAWINGS NUMBER _9_ AND _10b_ FOR SIDEWALK, PAVEMENT AND CURBING.
2. SANITARY SEWER ONLY SHOWN WHERE IT HAS POTENTIAL OF CONFLICTING WITH PROPOSED STORM DRAINAGE IMPROVEMENTS.

No.	DATE	DESCRIPTION	DESIGNER	REVIEWER
1.	08/10/2023	REVISED STAMPED CONCRETE TO BRICK PAVER SIDEWALK	TJR	MGV

SEAL

SEAL

SCALE:
HORZ.: 1" = 5'
VERT.: 1"=5'
DATUM:
HORZ.:
VERT.:
5 2.5 0 5
GRAPHIC SCALE

FUSS & O'NEILL
146 HARTFORD ROAD
MANCHESTER, CONNECTICUT 06040
860.646.2469
www.fando.com

CITY OF NORWALK

CROSS-SECTION PLANS

EAST WALL STREET IMPROVEMENTS

NORWALK CONNECTICUT

PROJ. No.: L102-004
DATE: JUNE 2023

XCS-04

File: J:\DWG\P2021\03\01A10\Civil\Plan\East Wall St\20210301.A10_TYP01.dwg Layout: XSC-04 Plotted: 2023-08-10 3:27 PM Saved: 2023-08-10 3:26 PM User: trudolph
PC3: AUTOCAD PDF (GENERAL DOCUMENTATION).PC3 STB/CTB: FO.STB
LAYER STATE:
MS VIEW:

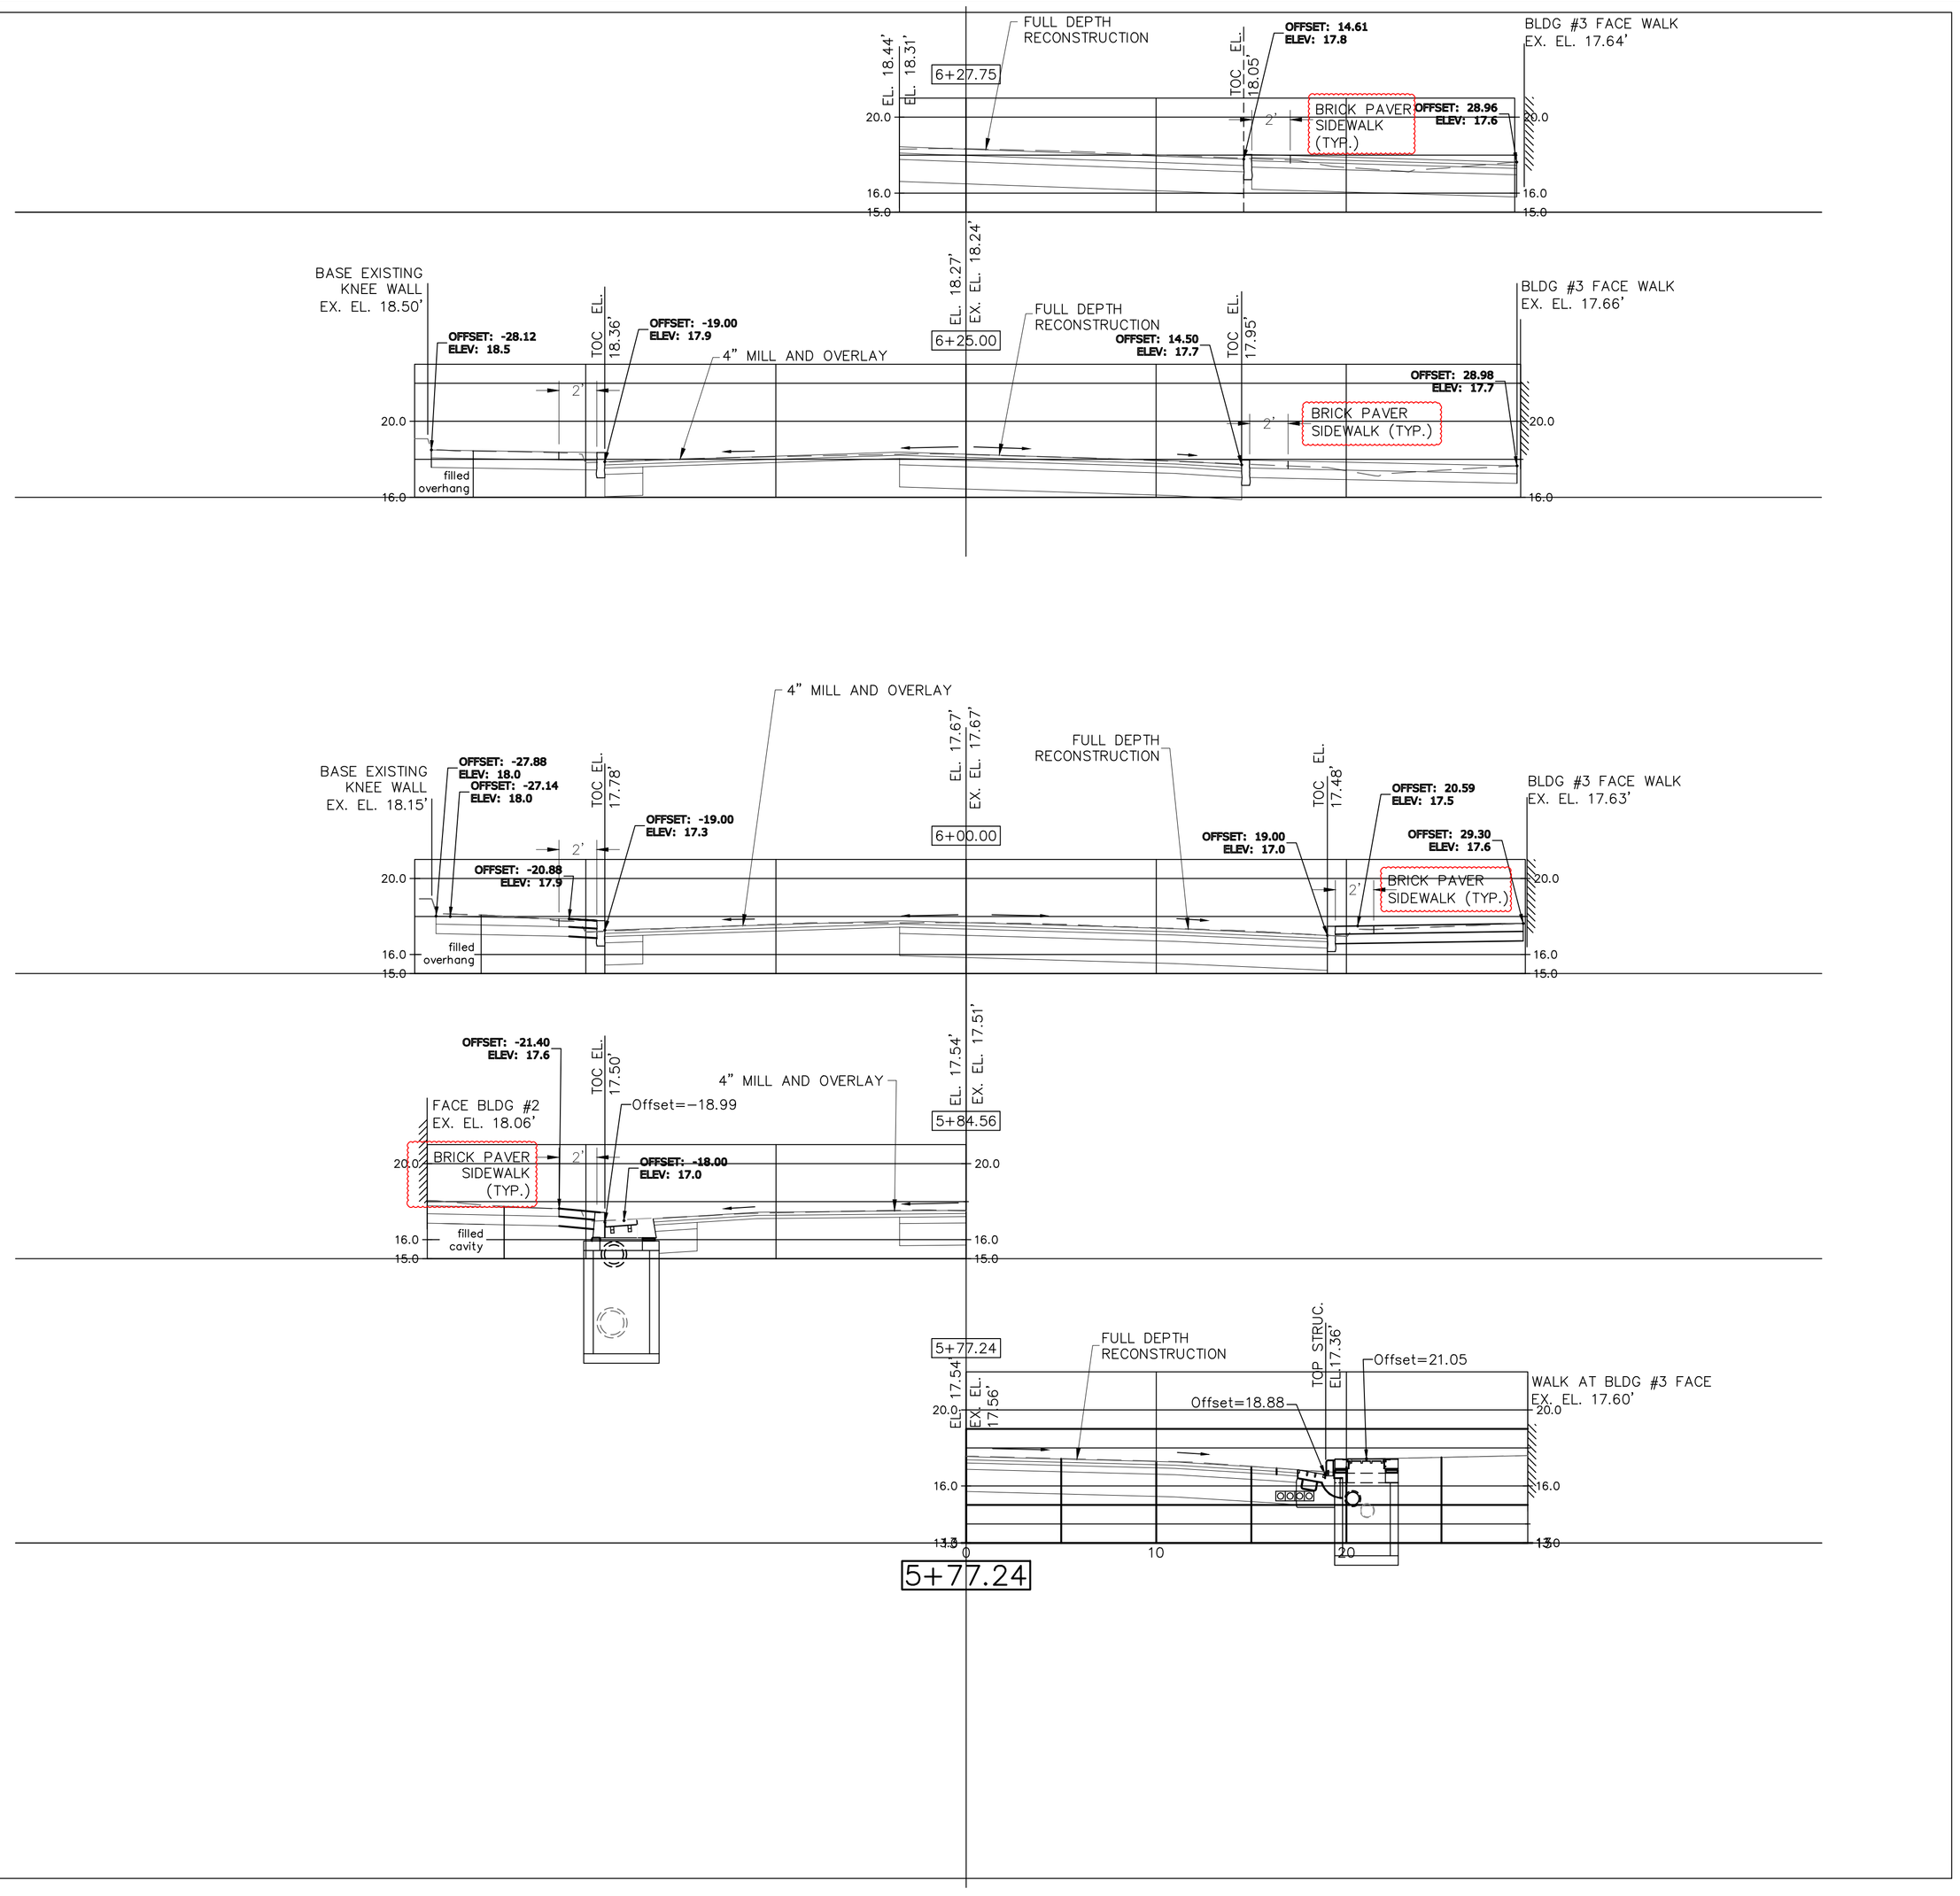

NOTE: 1. SEE CITY STANDARD DETAIL DRAWINGS NUMBER _9_ AND _10b_ FOR SIDEWALK, PAVEMENT AND CURBING.
2. SANITARY SEWER ONLY SHOWN WHERE IT HAS POTENTIAL OF CONFLICTING WITH PROPOSED STORM DRAINAGE IMPROVEMENTS.

No.	DATE	DESCRIPTION	DESIGNER	REVIEWER
1.	8/10/2023	REVISED STAMPED CONCRETE TO BRICK PAVER SIDEWALK	TJR	MGV

SEAL

SEAL

SCALE:
HORZ.: 1" = 5'
VERT.: 1"=5'
DATUM:
HORZ.:
VERT.:
5 2.5 0 5
GRAPHIC SCALE

FUSS & O'NEILL
146 HARTFORD ROAD
MANCHESTER, CONNECTICUT 06040
860.646.2469
www.fando.com

CITY OF NORWALK

CROSS-SECTION PLANS

EAST WALL STREET IMPROVEMENTS

NORWALK CONNECTICUT

PROJ. No.: L102-004
DATE: JUNE 2023

XCS-05

File: J:\DWG\P2021\0301\A10\Civil\Plan\East Wall St\20210301 A10_TYP01.dwg Layout: XSC-05 Plotted: 2023-08-10 3:27 PM Saved: 2023-08-10 3:26 PM User: trudolph
PC3: AUTOCAD PDF (GENERAL DOCUMENTATION).PC3 STB/CTB: FO.STB
LAYER STATE:
MS VIEW:
Page 7 of 10, Addendum 1 4394-FINAL

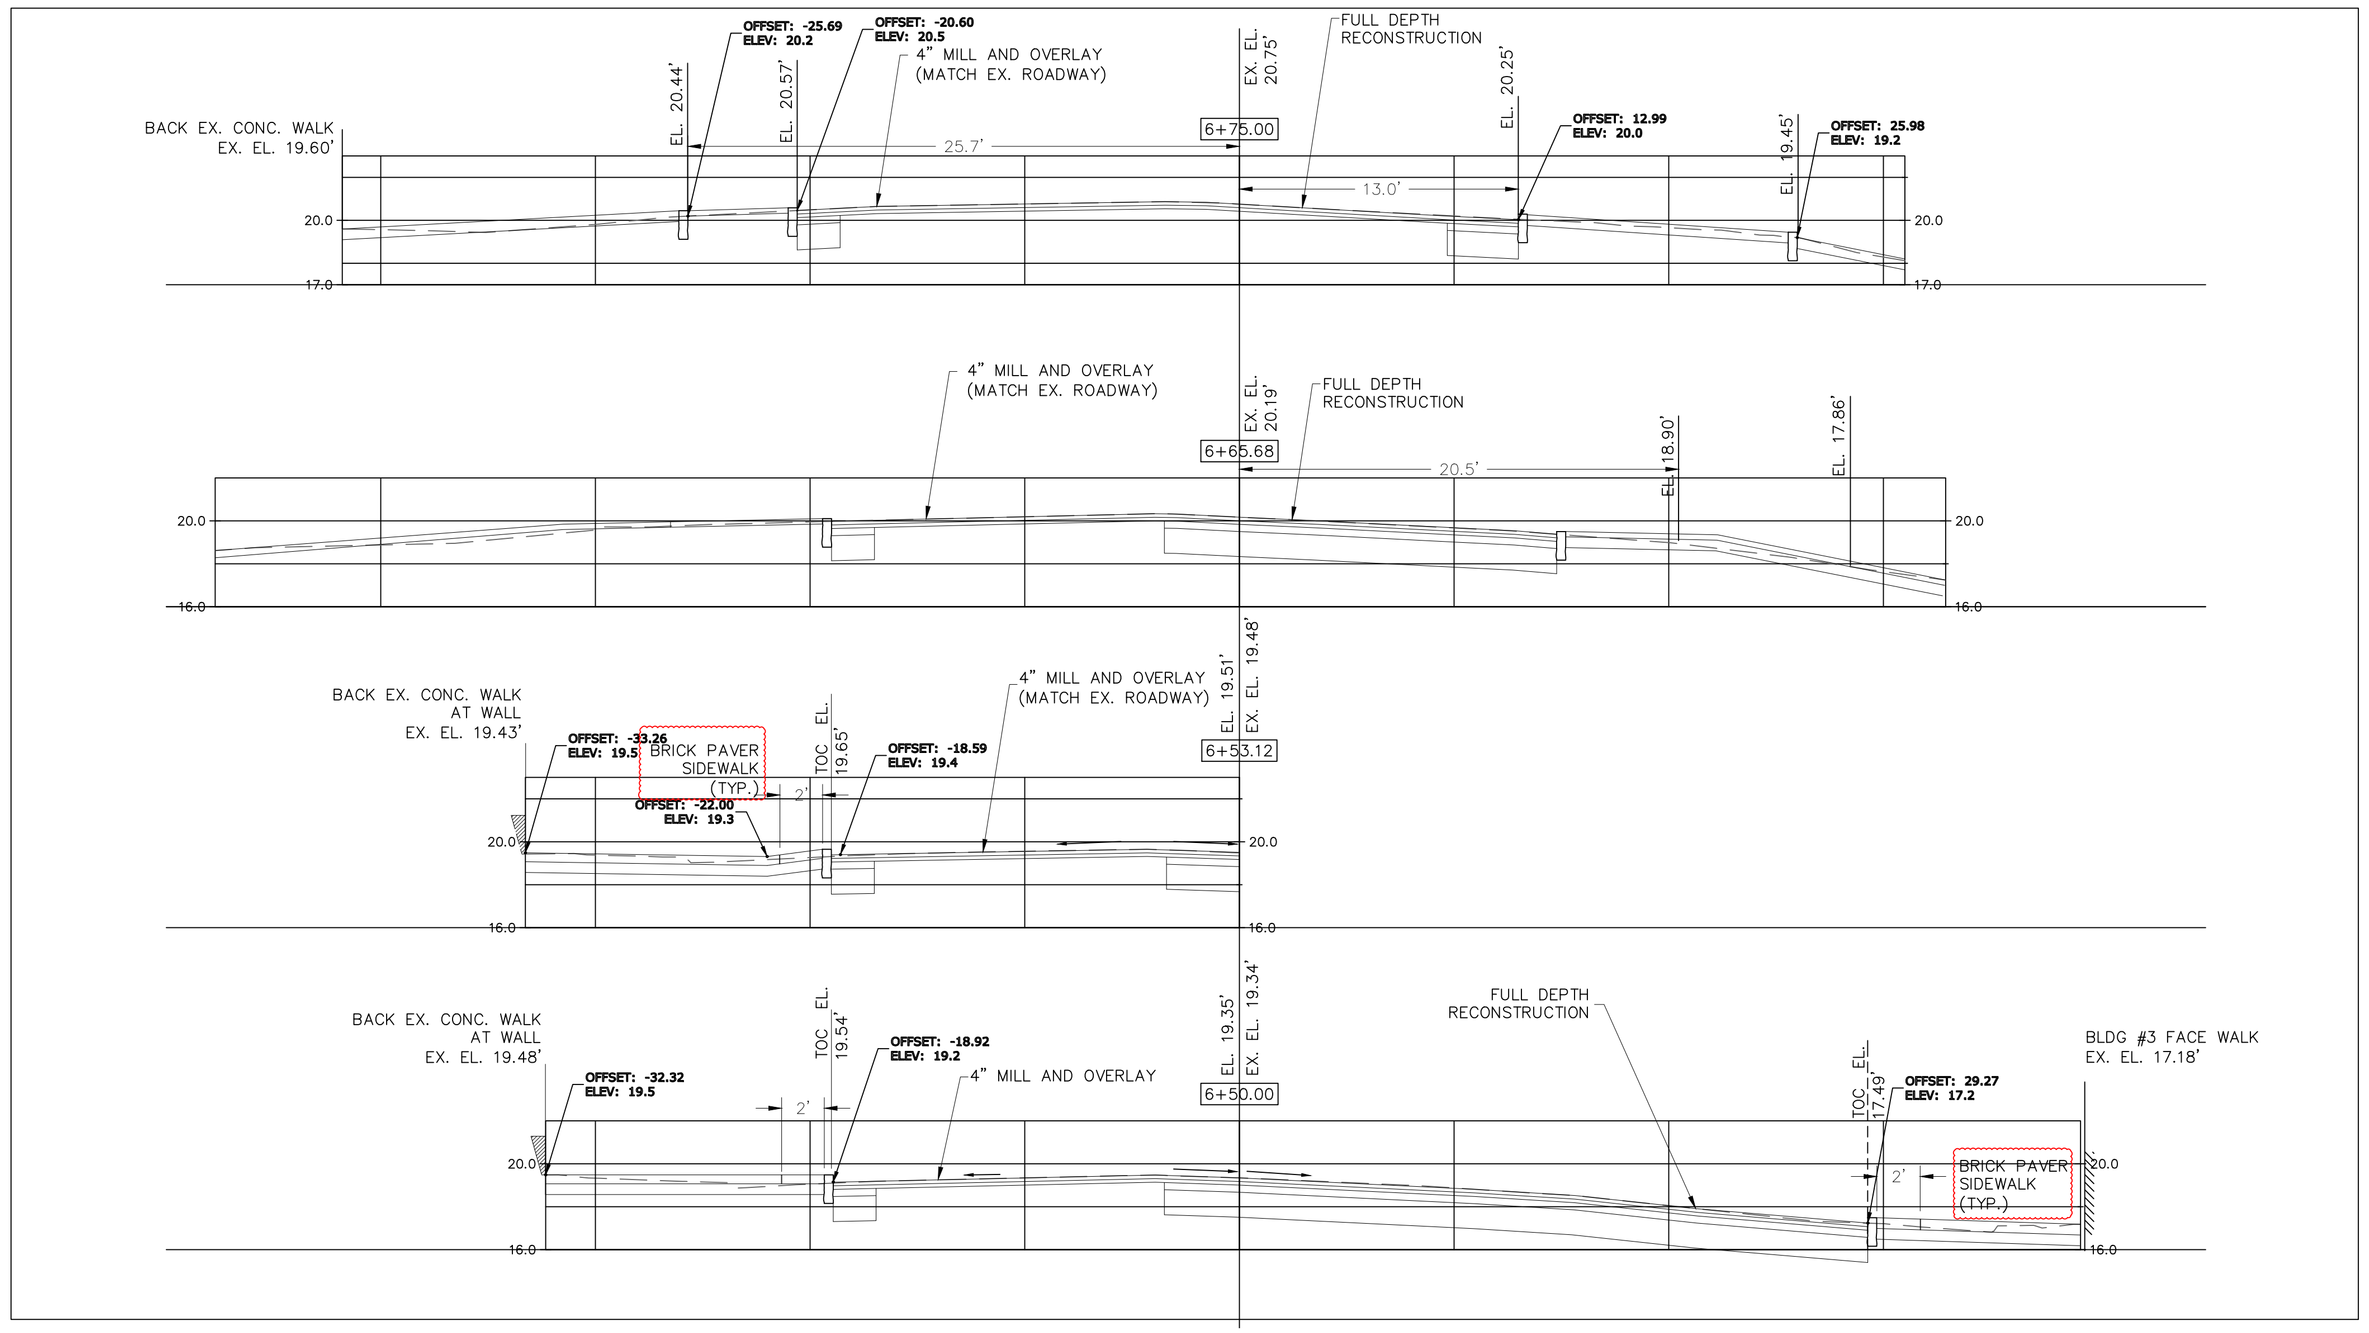

NOTE: 1. SEE CITY STANDARD DETAIL DRAWINGS NUMBER _9_ AND _10b_ FOR SIDEWALK, PAVEMENT AND CURBING.
2. SANITARY SEWER ONLY SHOWN WHERE IT HAS POTENTIAL OF CONFLICTING WITH PROPOSED STORM DRAINAGE IMPROVEMENTS.

No.	DATE	DESCRIPTION	DESIGNER	REVIEWER
1.	8/10/2023	REVISED STAMPED CONCRETE TO BRICK PAVER SIDEWALK	TJR	MGV

SEAL

SEAL

SCALE:
HORZ.: 1" = 5'
VERT.: 1"=5'
DATUM:
HORZ.:
VERT.:
5 2.5 0 5
GRAPHIC SCALE

FUSS & O'NEILL
146 HARTFORD ROAD
MANCHESTER, CONNECTICUT 06040
860.646.2469
www.fando.com

CITY OF NORWALK

CROSS-SECTION PLANS

EAST WALL STREET IMPROVEMENTS

NORWALK CONNECTICUT

PROJ. No.: L102-004
DATE: JUNE 2023

XCS-06

Page 8 of 10, Addendum 1 4304-FINAL
File: J:\DWG\P2021\03\01A\10\Civil\Plan\East Wall St\202103O1.A10_TYP01.dwg Layout: XSC-06 Plotted: 2023-08-10 3:28 PM Saved: 2023-08-10 3:26 PM User: trudolph
MS VIEW: LAYER STATE: PC3: AUTOCAD PDF (GENERAL DOCUMENTATION).PC3 STB/CTB: FO.STB

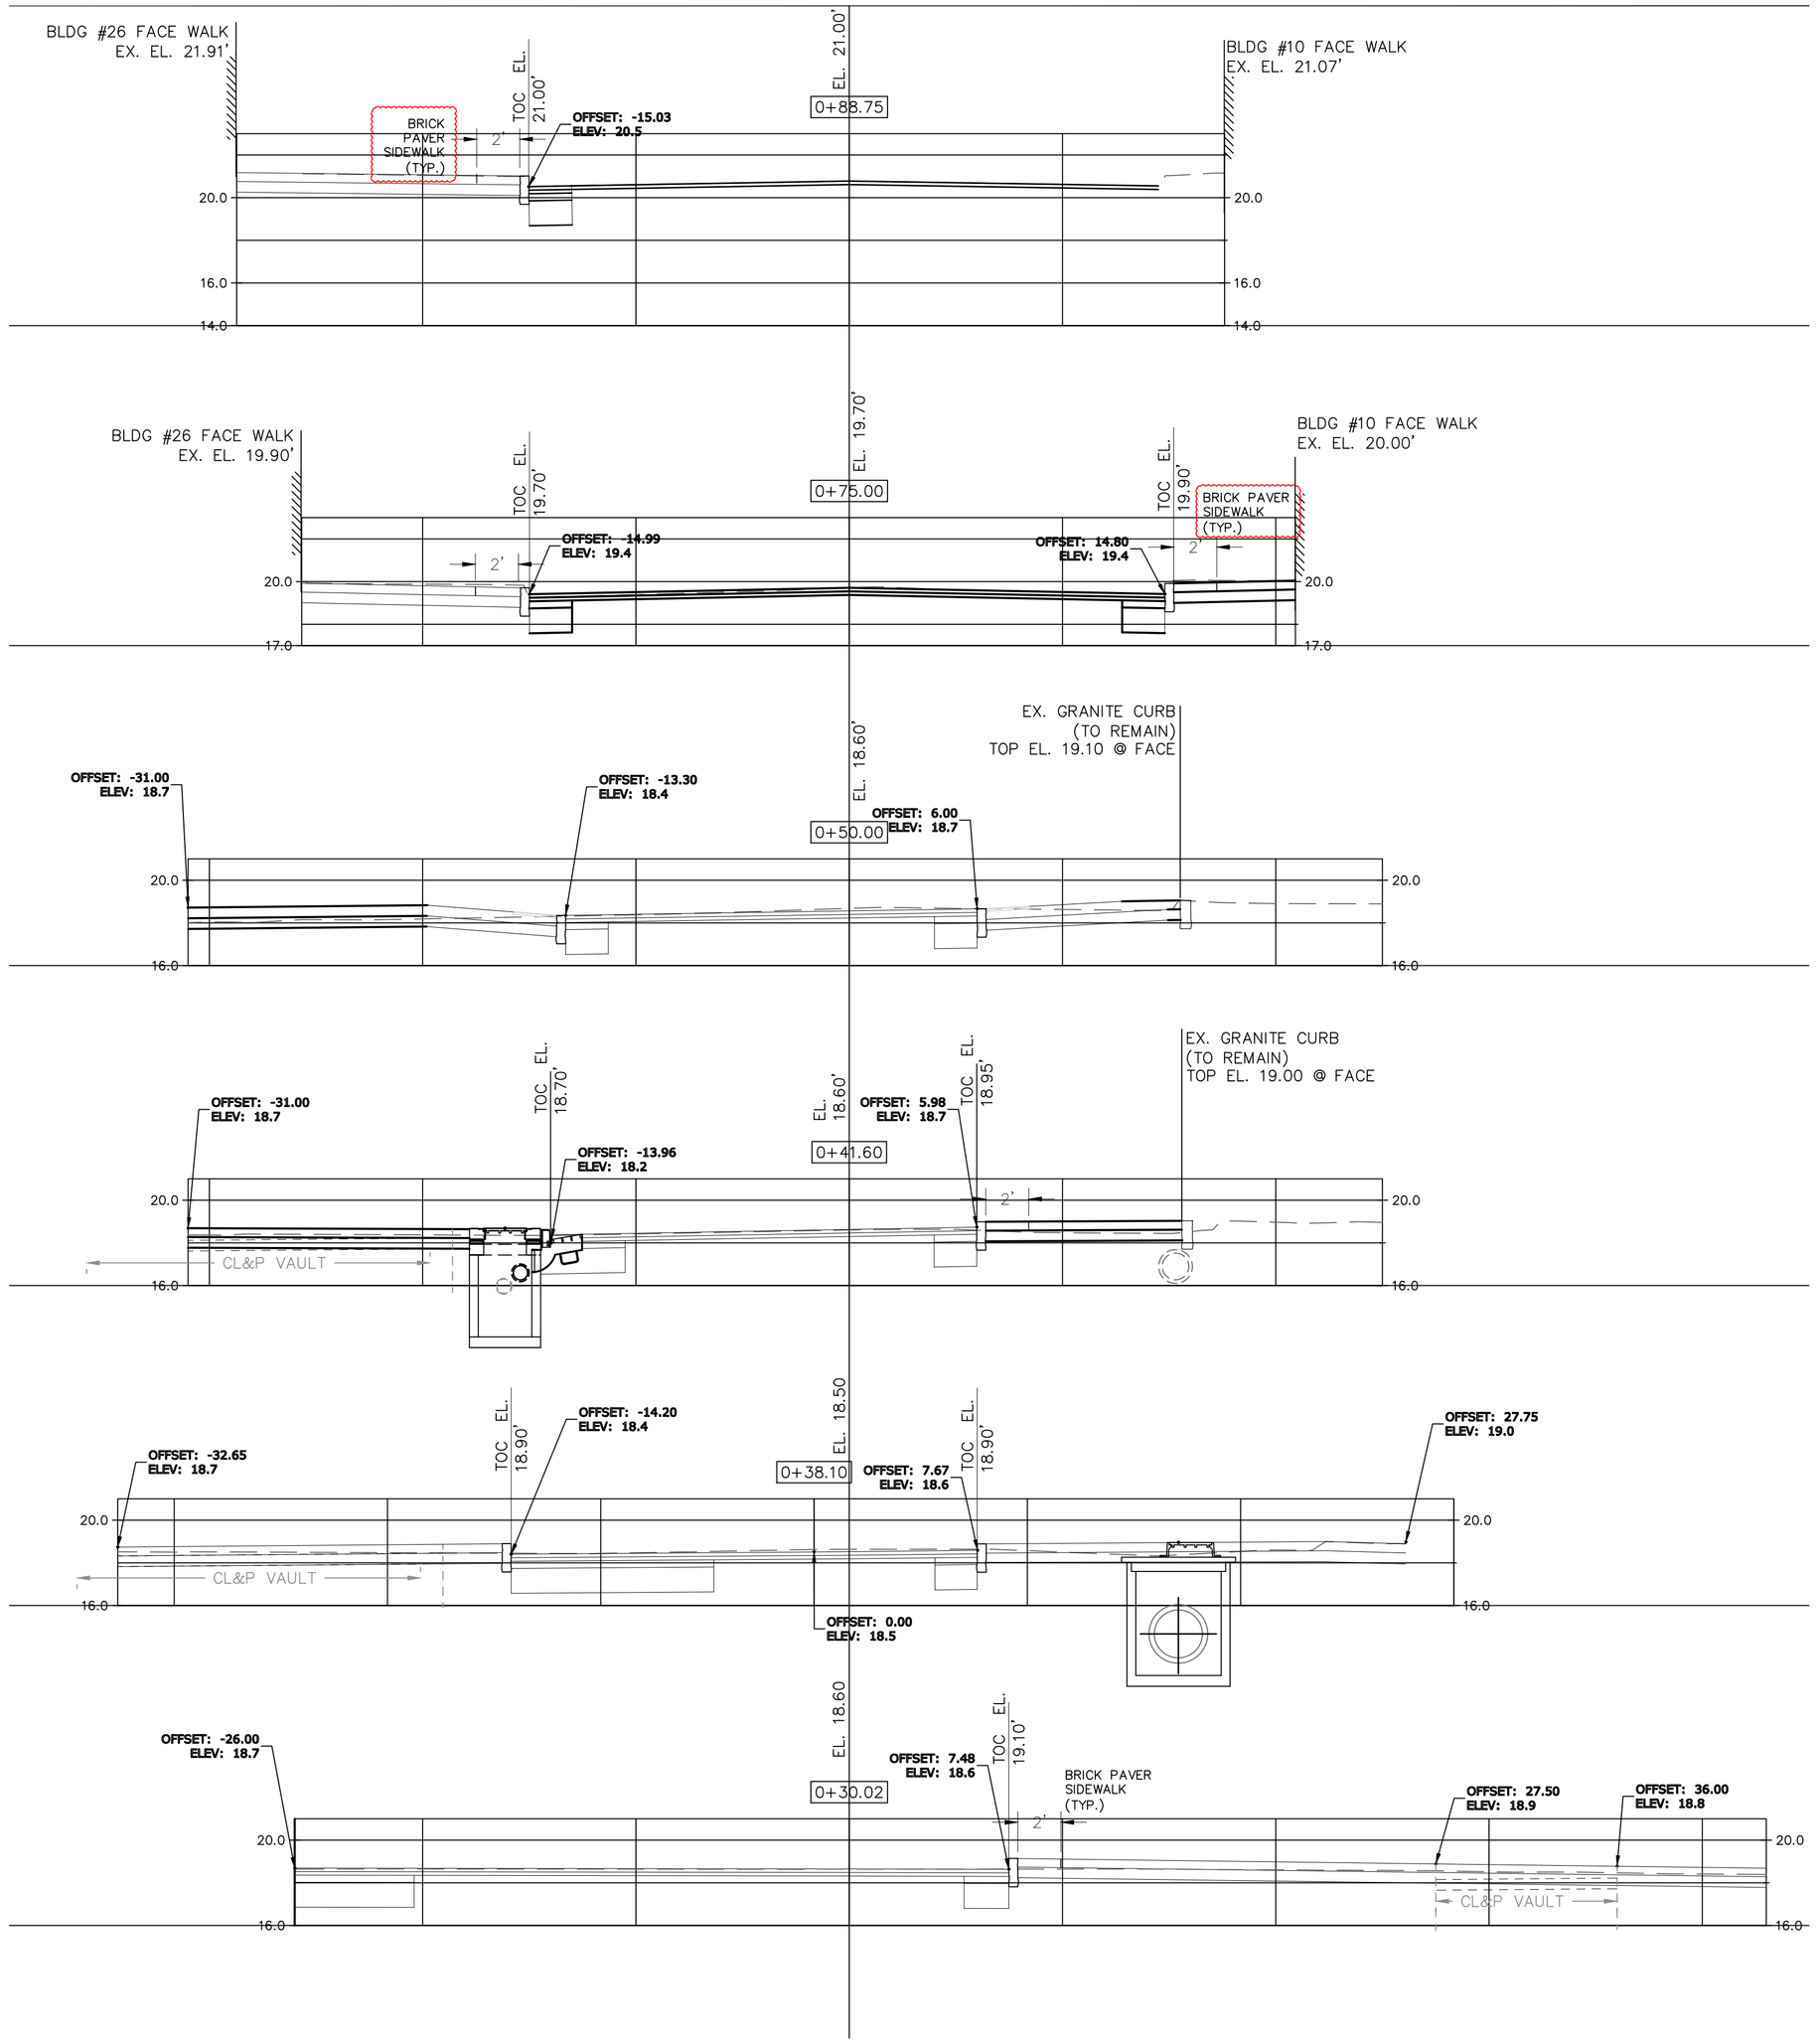

NOTE: 1. SEE CITY STANDARD DETAIL DRAWINGS NUMBER _9_ AND _10b_ FOR SIDEWALK, PAVEMENT AND CURBING.
2. SANITARY SEWER ONLY SHOWN WHERE IT HAS POTENTIAL OF CONFLICTING WITH PROPOSED STORM DRAINAGE IMPROVEMENTS.

No.	DATE	DESCRIPTION	DESIGNER	REVIEWER
1.	8/10/2023	REVISED STAMPED CONCRETE TO BRICK PAVER SIDEWALK	TJR	MGV

SEAL

SEAL

SCALE:
HORZ.: 1" = 5'
VERT.: 1"=5'
DATUM:
HORZ.:
VERT.:
5 2.5 0 5
GRAPHIC SCALE

FUSS & O'NEILL
146 HARTFORD ROAD
MANCHESTER, CONNECTICUT 06040
860.646.2469
www.fando.com

CITY OF NORWALK

CROSS-SECTION PLANS - HIGH STREET

EAST WALL STREET IMPROVEMENTS

NORWALK CONNECTICUT

PROJ. No.: L102-004
DATE: JUNE 2023

XCS-07

Page 9 of 10, Addendum 1 4304-FINAL
File: J:\DWG\P2021\0301\A10\Civil\Plan\East Wall St\20210301.A10_TYP01.dwg Layout: XSC-07 Plotted: 2023-08-10 3:28 PM Saved: 2023-08-10 3:26 PM User: trudolph
PC3: AUTOCAD PDF (GENERAL DOCUMENTATION).PC3 STB/CTB: FO.STB
LAYER STATE:
MS VIEW:

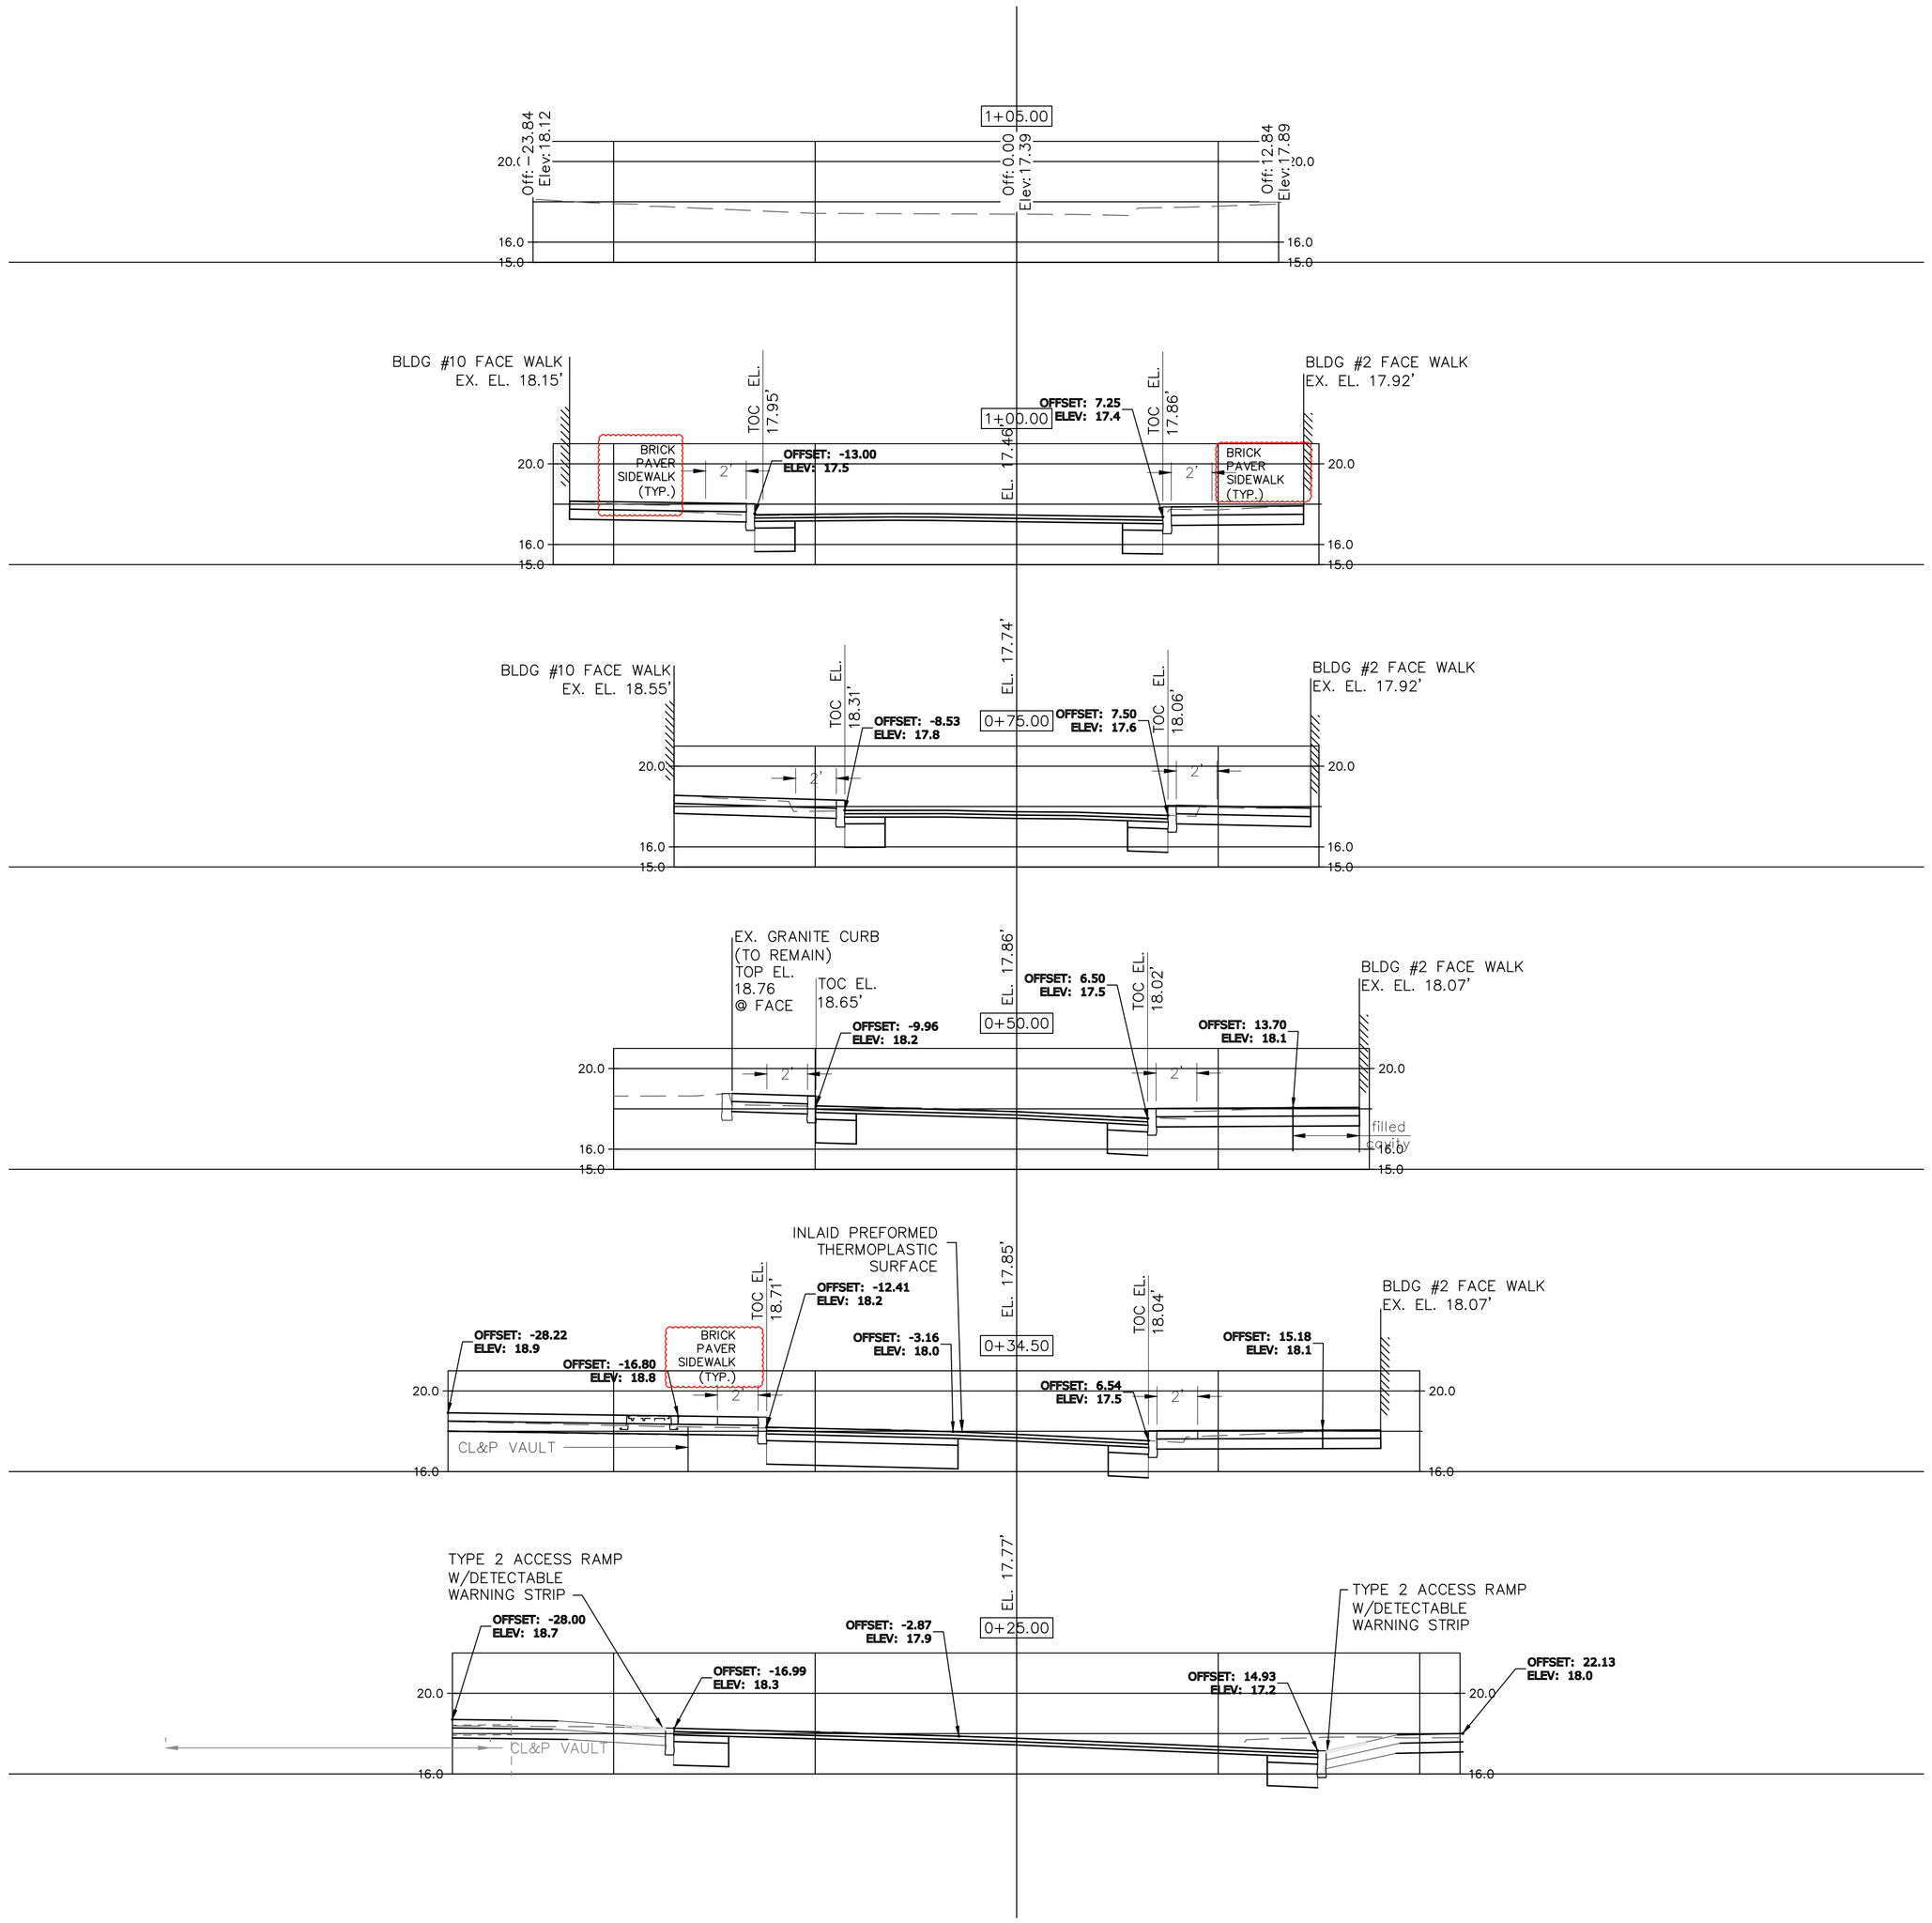

NOTE: 1. SEE CITY STANDARD DETAIL DRAWINGS NUMBER _9_ AND _10b_ FOR SIDEWALK, PAVEMENT AND CURBING.
2. SANITARY SEWER ONLY SHOWN WHERE IT HAS POTENTIAL OF CONFLICTING WITH PROPOSED STORM DRAINAGE IMPROVEMENTS.

No.	DATE	DESCRIPTION	DESIGNER	REVIEWER
1.	8/10/2023	REVISED STAMPED CONCRETE TO BRICK PAVER SIDEWALK	TJR	MGV

SEAL

SEAL

SCALE:
HORZ.: 1" = 5'
VERT.: 1"=5'
DATUM:
HORZ.:
VERT.:
5 2.5 0 5
GRAPHIC SCALE

FUSS & O'NEILL
146 HARTFORD ROAD
MANCHESTER, CONNECTICUT 06040
860.646.2469
www.fando.com

CITY OF NORWALK

CROSS-SECTION PLANS - KNIGHT STREET

EAST WALL STREET IMPROVEMENTS

NORWALK CONNECTICUT

PROJ. No.: L102-004
DATE: JUNE 2023

XCS-08

File: J:\DWG\P2021\03\01\A10\Civil\Plan\East Wall St\20210301.A10_TYP01.dwg Layout: XSC-08 Plotted: 2023-08-10 3:28 PM Saved: 2023-08-10 3:26 PM User: trudolph
PC3: AUTOCAD PDF (GENERAL DOCUMENTATION).PC3 STB/CTB: FO.STB
LAYER STATE:
MS VIEW:
Page 10 of 10, Addendum 1 4304-FINAL